


STATE OF KANSAS
STATE CORPORATION COMMISSION

WELL PLUGGING RECORD

Give All Information Completely
Make Required Affidavit
Mail or Deliver Report to
Conservation Division
State Corporation Comm.
245 North Water
Wichita, KS 67202

Pawnee County. Sec. 30 Twp. 21S Rge. 15 X/W
Location as "NE/CNW $\frac{1}{2}$ SW $\frac{1}{2}$ " or footage from lines _____
NW NE SE
Lease Owner Benson Mineral Group, Inc.
Lease Name Unruh Well No. 2
Office Address 3200 Anaconda Tower, 555 17th St. Denver, CO
Character of Well (Completed as Oil, Gas or Dry Hole) 80202

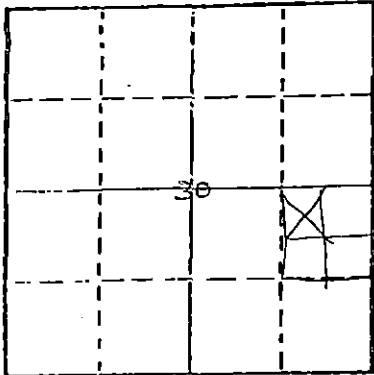

Locate well correctly on above
Section Plat

Dry Hole
Date Well completed 7/3/78 19
Application for plugging filed 7/3/78 19
Application for plugging approved 7/3/78 19
Plugging commenced 7/3/78 19
Plugging completed 7/3/78 19
Reason for abandonment of well or producing formation _____

Dry Hole
If a producing well is abandoned, date of last production _____ 19

Was permission obtained from the Conservation Division or its agents before plugging was commenced? Yes

Name of Conservation Agent who supervised plugging of this well Leo Massey
Producing formation _____ Depth to top _____ Bottom _____ Total Depth of Well 2030'
Show depth and thickness of all water, oil and gas formations.

OIL, GAS OR WATER RECORDS

CASING RECORD

FORMATION	CONTENT	FROM	TO	SIZE	PUT IN	PULLED OUT
				7"	936'	none

Describe in detail the manner in which the well was plugged, indicating where the mud fluid was placed and the method or methods used in introducing it into the hold. If cement or other plugs were used, state the character of same and depth placed, from _____ feet to _____ feet for each plug set.

drilling mud to 420', 30 sx common cement, drilling mud to 40', 8 sx cement, 2 sx cement at rathole, 2 sx cement at mousehole.

RECEIVED
STATE CORPORATION COMMISSION

JUL 24 1978

7-24-78

CONSERVATION DIVISION
Wichita, Kansas

(If additional description is necessary, use BACK of this sheet)

Name of Plugging Contractor B & N Drilling, Division of Benson Mineral Group, Inc.

STATE OF KANSAS COUNTY OF MONTGOMERY, ss.
Lucille Shukers (employee of owner) or ~~(owner or operator)~~
of the above-described well, being first duly sworn on oath, says: That I have knowledge of the facts, statements, and matters herein contained and the log of the above-described well as filed and that the same are true and correct. So help me God.

(Signature) Lucille Shukers
Box 846, Independence, Ks. 67301
(Address)

SUBSCRIBED AND SWORN TO before me this 10th day of July, 1978

My commission expires 9/24/78

Jane McNickle
Notary Public.

JANE McNICKLE
NOTARY
PUBLIC
Montgomery County, Kansas