


STATE OF KANSAS  
STATE CORPORATION COMMISSION

WELL PLUGGING RECORD

Give All Information Completely  
Make Required Affidavit  
Mail or Deliver Report to  
Conservation Division  
State Corporation Comm.  
245 North Water  
Wichita, KS 67202

Pawnee County. Sec. 2 Twp. 21 Rge. 16W E/W  
Location as "NE/CNW 1/4 SW 1/4" or footage from lines  
SW NE SE  
Lease Owner Braden Deem Inc.  
Lease Name Blasi Well No. 4  
Office Address 200 East First Wichita Ks. 67202  
Character of Well (Completed as Oil, Gas or Dry Hole) \_\_\_\_\_

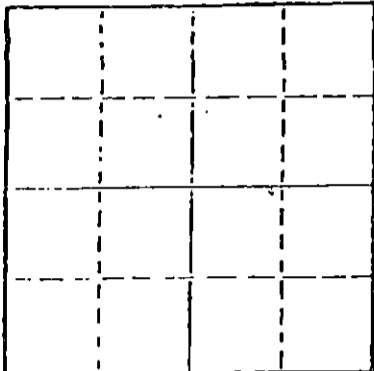

Locate well correctly on above  
Section Plot

Oil  
Date Well completed 8/ 1962  
Application for plugging filed 4/ 1979  
Application for plugging approved 4/ 1979  
Plugging commenced 5/10 1979  
Plugging completed 5/15 1979  
Reason for abandonment of well or producing formation \_\_\_\_\_

Dry  
If a producing well is abandoned, date of last production 8/9 1979  
Was permission obtained from the Conservation Division or its agents before plugging was commenced? Yes

Name of Conservation Agent who supervised plugging of this well Marion Schmidt  
Producing formation Arbuckle Depth to top 3796 Bottom 3804 Total Depth of Well 3804  
Show depth and thickness of all water, oil and gas formations.

OIL, GAS OR WATER RECORDS

CASING RECORD

FORMATION	CONTENT	FROM	TO	SIZE	PUT IN	PULLED OUT
	Surface	0	1008	8 5/8		
		0	3796	5 1/2		3002

Describe in detail the manner in which the well was plugged, indicating where the mud fluid was placed and the method or methods used in introducing it into the hold. If cement or other plugs were used, state the character of same and depth placed, from \_\_\_\_\_ feet to \_\_\_\_\_ feet for each plug set.

Filled 50 ft. sand in bottom and dumped 5 sx, cement

Set plug at 500 ft. filled to bottom of cellar with 6 yds. of

Readymix cement

RECEIVED  
STATE CORPORATION COMMISSION

MAY 8 1979

5-18-79

(If additional description is necessary, use BACK of this sheet)  
Name of Plugging Contractor Nicholas Casing Pulling  
Box 373 Geneseo Kansas 67444

STATE OF KANSAS COUNTY OF RICE, ss.  
George A. Nicholas (employee of owner) or (owner or operator)  
of the above-described well, being first duly sworn on oath, says: That I have knowledge of the facts, statements, and matters herein contained and the log of the above-described well as filed and that the same are true and correct. So help me God.

(Signature) George A. Nicholas

(Address)

SUBSCRIBED AND SWORN TO before me this 17th day of May, 19 79



Steven K Prickett

Notary Public.

My commission expires August 29, 1982

INDEXED

15-145-19039-0000

ORIGINAL

KANSAS GEOLOGICAL SOCIETY  
KANSAS WELL LOG BUREAU - KANSAS WELL SAMPLE BUREAU  
KANSAS GEOLOGICAL SOCIETY BUILDING  
508 EAST MURDOCK WICHITA, KANSAS

NOV 26 1966

COMPANY ALPINE OIL & ROYALTY

SEC. 2 T. 21 R. 16W

FARM Blasi

NO. 4

LOC. SW NE SE

TOTAL DEPTH 3804'

COUNTY Pawnee

COMM. 1-2-64


COMP. 2-6-64

KANSAS

SHOT OR TREATED

CONTRACTOR Quaker Drlg.

ISSUED 11-26-66

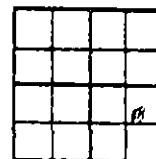

CASING

20	10	
15	8 5/8	1008' w/475 sx cem.
12	6	
13	5 1/2	3796' w/100 sx cem.

ELEVATION 199' KB

PRODUCTION Pmp. 90  
BOPD, NW, GR 37.2:  
(Arb 3796-3804)

FIGURES INDICATE BOTTOM OF FORMATIONS

COMPLETE DRILLERS LOG NOT AVAILIABLE.

TOPS: SCOUT	SAMPLE
Anhydrite	999
Heebner	3343
Brown Lime	3434
Lansing	3446
E/Kansas City	3688
Viola	3710
Simpson	3756
Arbuckle	3795

RECEIVED  
STATE CORPORATION COMMISSION

APR 26 1979

CONSERVATION DIVISION  
Wichita, Kansas

YOUR COPY