

WELL PLUGGING RECORD

Give All Information Completely
Make Required Affidavit
Mail or Deliver Report to:
Conservation Division
State Corporation Commission
211 No. Broadway
Wichita, Kansas

Pawnee County. Sec. 21 Twp. 21 Rge. 15 (E) (W)^X

Location as "NE/CNW&SW" or footage from lines SW-SW-NW 330' N & 330' East of W/4 cor.

Lease Owner Mahoney Drilling Co., Inc.

Lease Name Dix Well No. 1

Office Address Box 1257

Character of Well (completed as Oil, Gas or Dry Hole) Gas

Date well completed 5/24 19 55

Application for plugging filed 6/9 19 67

Application for plugging approved 6/12 19 67


Plugging commenced 6/12 19 67

Plugging completed 6/15 19 67

Reason for abandonment of well or producing formation Non-commercial

If a producing well is abandoned, date of last production 19

Was permission obtained from the Conservation Division or its agents before plugging was commenced? Yes

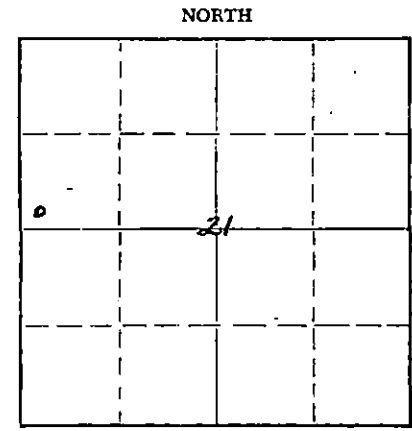

Locate well correctly on above Section Plat

Name of Conservation Agent who supervised plugging of this well Leo Massey

Producing formation Depth to top 3741 Bottom 61 Total Depth of Well 3856 Feet

Show depth and thickness of all water, oil and gas formations.

OIL, GAS OR WATER RECORDS

CASING RECORD

FORMATION	CONTENT	FROM	TO	SIZE	PUT IN	PULLED OUT
	Surface	0	731	8 5/8	731	0
	Casing	0	3856	5 1/2	3856	1600

Describe in detail the manner in which the well was plugged, indicating where the mud fluid was placed and the method or methods used in introducing it into the hole. If cement or other plugs were used, state the character of same and depth placed, from feet to feet for each plug set.

Mix 15 sks. cement to plug off perforations, stop plug at 3660.
Pulled pipe in two at 1600 ft., lay down same to 650 and circulated same with gell at 650. Lay down to 350 and displace 45 sks of cement at 450. Lay down all casing 52 joints. Bridge and 10 sks. cement at 40' to 0.

RECEIVED
STATE CORPORATION COMMISSION

JUN 23 1967

CONSERVATION DIVISION
Wichita, Kansas

(If additional description is necessary, use BACK of this sheet)

Name of Plugging Contractor Sargents Casing Pulling Service

Address Box 506, Liberal, Kansas 67901

STATE OF KANSAS, COUNTY OF SEWARD, ss. Robert Sargent (employee of owner) or (owner or operator) of the above-described

well, being first duly sworn on oath, says: That I have knowledge of the facts, statements, and matters herein contained and the log of the above-described well as filed and that the same are true and correct. So help me God.


(Signature) Robert Sargent

Liberal, Kansas 67901 (Address)

21st day of June, 19 67

DeAnn Corbin Notary Public
My Commission expires Jan. 16, 1970

DeAnn Corbin Notary Public

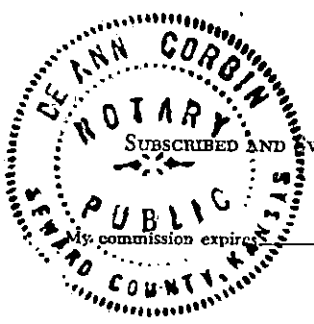

WELL RECORD IS: 145-00376-0000

Company: Oakes Service Oil Co. et al. Well No. 1 Farm Sec. 21 T. 21 R. 15N
 Location: 350' North and 330' East of W/4 Cor. Elevation 1952 (1950 Br.)
 County: Pender State: Kansas
 Drg. Comm. April 23, 1955 Contractor: Barber Drilling Company
 Drg. Comp. May 6, 1955 Acid None
 T.D. 3556' Initial Prod. 4-22-55 P. O. East S. 1. P. 11A76 (5-24-55) P. O. I. P. 2410'

TESTING RECORDS

6-5/51 @ 431' cor. 400 psi constant
 5-1/51 @ 3556' cor. 185 psi constant

FORMATION RECORDS

30-320	red bed
290	red bed
270	red bed
0	red bed

3560 RHA = 3556 RHM

- Corr. Topair 2975'
 - Corr. Hebbert 3319'
 - Corr. Dodge 3350'
 - Corr. Douglas 3349'
 - Corr. Brown limestone 3173'
 - Corr. Lansing 3171'
 - Corr. East Penn. sand 3141'
 - Corr. Cherty Conglomerate 2755'
 - Corr. Simpson shale 2768'
 - Corr. Limestone 2506'
 - 20'
 - Corr. Topal depth 2856'
- Milled cement to 3540 S. 1. P.
 Filled hole with water.
 Zoned. 36 zones 3747-47'. Sand, var. load.
 5-13-55: Gas wt. 3.762 lb. O. P. gas.
 Gas density 28 lb./cu. ft.
 1958, S. 1. P. 1100'.
 5-24-55: Gas wt. 4.020 lb. O. P. liquid.
 Gas density 28 lb./cu. ft.
 2975'
 3000'

RECEIVED
 STATE CORPORATION COMMISSION
 JUN 12 1967
 CONSERVATION DIVISION
 WICHITA, KANSAS