


STATE OF KANSAS  
STATE CORPORATION COMMISSION

Give All Information Completely  
Make Required Affidavit  
Mail or Deliver Report to:  
Conservation Division  
State Corporation Commission  
P. O. Box 17027  
Wichita, Kansas 67217  
NORTH

WELL PLUGGING RECORD

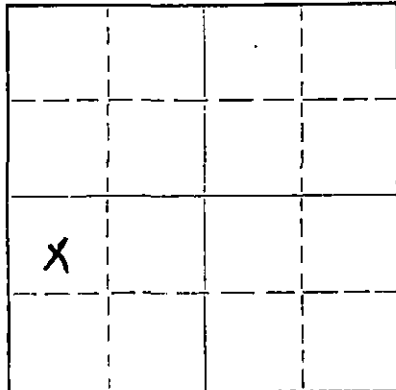

Locate well correctly on above  
Section Plat

Hodgeman County. Sec. 9 Twp. 21 Rge. 22 (E) W (W)  
Location as "NE/CNW/SW" or footage from lines C NW SW  
Lease Owner Pickrell Drlg. Co. ; Wichita, Kansas 67202  
Lease Name Cox 'A' Well No. 1  
Office Address 705 Fourth National Bank Building  
Character of Well (completed as Oil, Gas or Dry Hole) Oil  
Date well completed August 6 1959  
Application for plugging filed July 1974  
Application for plugging approved July 1974  
Plugging commenced July 27 1974  
Plugging completed August 27 1974  
Reason for abandonment of well or producing formation Depleted

If a producing well is abandoned, date of last production 6-15- 1973  
Was permission obtained from the Conservation Division or its agents before plugging was commenced? Yes

Name of Conservation Agent who supervised plugging of this well Edgar Eves  
Producing formation Mississippian Depth to top 4349(\*) Bottom 4359(\*) Total Depth of Well 4503 Feet  
Show depth and thickness of all water, oil and gas formations. (\*) Perfs.

OIL, GAS OR WATER RECORDS

CASING RECORD

FORMATION	CONTENT	FROM	TO	SIZE	PUT IN	PULLED OUT
				8 5/8"	218	None
				5 1/2"	4500	407

9-11-74  
STATE CORPORATION COMMISSION  
SEP 1 1974  
CONSERVATION DIVISION  
Wichita, Kansas

Describe in detail the manner in which the well was plugged, indicating where the mud fluid was placed and the method or methods used in introducing it into the hole. If cement or other plugs were used, state the character of same and depth placed, from \_\_\_\_\_ feet to \_\_\_\_\_ feet for each plug set.

July 27, 1974 Plugged off bottom. Dumped sand to 4200'. Mixed and dumped 5 sx of cement.

August 27, 1974 Plugged off top. Allied Cementing Co. mixed and pumped down 8 5/8" surface casing; 3 sx of hulls, 20 sx of gel, 70 sx of cement, 10 sx of gel and 70 sx of cement.

(If additional description is necessary, use BACK of this sheet)

Name of Plugging Contractor RUSS CASING PULLING, INC.  
Address P. O. Box 1082 ; Great Bend, Kansas 67530

STATE OF Kansas, COUNTY OF Sedgwick, ss.  
Jack Gurley (employee of owner) or (owner or operator) of the above-described well, being first duly sworn on oath, says: That I have knowledge of the facts, statements, and matters herein contained and the log of the above-described well as filed and that the same are true and correct. So help me God.

(Signature) Jack Gurley  
Pickrell Drilling Company, 705 Fourth National Bank Building, Wichita, Kansas 67202

SUBSCRIBED AND SWORN TO before me this 10th day of September, 1974

My commission expires \_\_\_\_\_  
HELEN L. MARTIN  
NOTARY PUBLIC  
Sedgwick County, Kans.  
My Comm. Expires Aug. 19, 1974

Helen L. Martin  
Helen L. Martin Notary Public.

*File 10-1*  
**ROTARY DRILLING LOG**

15.083-10182-0000

COMPANY: Pickrell Drilling Company  
705 Fourth National Bank Building  
Wichita, Kansas

Rotary Drilling Commenced 7/7/59

Rotary Drilling Completed 8/3/59

LOCATION: C-NW-SW Sec. 9-21s-22w  
Hodgeman County, Kansas  
Cox #1

CONTRACTOR: **PICKRELL DRILLING COMPANY**  
Wichita, Kansas

CASING RECORD: 218' of 8 5/8" casing (10 jts. 32#) set with 115 sacks cement.  
cement, circulated.

5 1/2" 14# National Tub. casing set at 4499' (134jts.) cemented with  
125 sacks 2% gel.

**LOG**

(Figures indicate bottom of formation — measurements from top of rotary bushing.)

Sandy surface soil	65'	Circ. for samples:
Black shale and clay	220'	
Red Rock and Shale	790'	4265'
<del>XXX</del> Anhydrite	800'	4355'
Shale and Sand	1500'	4360'
Shale and Shells	1750'	4364'
Shale	2010'	4374'
Shale and Shells	2255'	4444'
Lime and Shale	2580'	4506'
Lime	2700'	
Lime and Shale	2900'	
Chalk, Lime, and Shale	3035'	
Lime and Shale	3805'	
Lime	3905'	
Lime and Shale	3939'	
Lime	3978'	
Lime and Shale	4351'	
Mississippi	4503'	
Viola	4506'	

Slope Test;

2000' 0°  
3000' 0°  
4000' 0°

S.L.M.

2000' O.K.  
3000' O.K.  
4000' O.K.

**RECEIVED**  
STATE CORPORATION COMMISSION  
OCT 15 1973  
CONSERVATION DIVISION  
Wichita, Kansas

The undersigned, G. W. Pike, Attorney-in-Fact for PICKRELL DRILLING COMPANY, hereby certifies in behalf of said Company, that the above is a true and correct log of the formation encountered in drilling the above well as reflected by the Daily Drilling Reports.

**PICKRELL DRILLING COMPANY**

By G. W. Pike  
Attorney-in-Fact

STATE OF KANSAS }  
COUNTY OF SEDGWICK } ss.:

On this 7th day of August, 19 59, before me the undersigned, a Notary Public, in and for the County and State aforesaid, personally appeared G. W. Pike, to me known to be the identical person who subscribed the name of PICKRELL DRILLING COMPANY to the foregoing instrument as its Attorney-in-Fact and acknowledged to me that he executed the same as his free and voluntary act and deed, and as the free and voluntary act and deed of such company, for the uses and purposes therein set forth.

Given under my hand and seal of office the day and year last above written.

My commission expires: October 15, 1962

Judith L. Palmer  
Notary Public