

STATE OF KANSAS
STATE CORPORATION COMMISSION

Form CP-4

Give All Information Completely
Make Required Affidavit
Mail or Deliver Report to:
Conservation Division
State Corporation Commission
P. O. Box 17027
Wichita, Kansas 67217
NORTH

WELL PLUGGING RECORD

Hodgeman County, Sec. 15 Twp. 21S Rge. (E) 22W(W)

Location as "NE/CNW/SW" or footage from lines. 100' SE C SE NW

Lease Owner Mack Oil Co.

Lease Name GUS Well No. 1

Office Address 812 Union Center, Wichita, KS 67202

Character of Well (completed as Oil, Gas or Dry Hole) dry hole

Date well completed 10-12-72 19

Application for plugging filed 10-12-72 19

Application for plugging approved 10-12-72 19


Plugging commenced 10-12-72 19

Plugging completed 10-12-72 19

Reason for abandonment of well or producing formation dry hole

If a producing well is abandoned, date of last production 19

Was permission obtained from the Conservation Division or its agents before plugging was commenced? yes

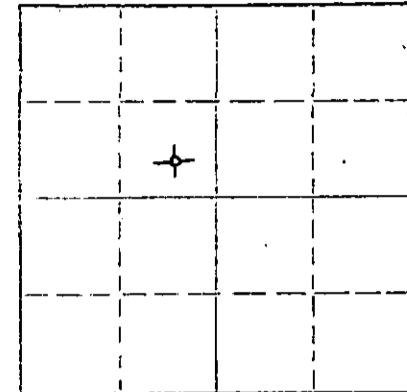

Locate well correctly on above Section Plat

Name of Conservation Agent who supervised plugging of this well Edgar J. Eves, Sublette, KS

Producing formation Depth to top Bottom Total Depth of Well 4450' Feet

Show depth and thickness of all water, oil and gas formations.

OIL, GAS OR WATER RECORDS

CASING RECORD

FORMATION	CONTENT	FROM	TO	SIZE	PUT IN	PULLED OUT
				8 5/8"	315'	

Describe in detail the manner in which the well was plugged, indicating where the mud fluid was placed and the method or methods used in introducing it into the hole. If cement or other plugs were used, state the character of same and depth placed, from feet to feet for each plug set.

Plugged w/80 sx. cement @ 800'
30 sx. cement @ 300'
15 sx. cement @ 45'

RECEIVED
STATE CORPORATION COMMISSION

OCT 16 1972

CONSERVATION DIVISION
Wichita, Kansas

10-16-72

Name of Plugging Contractor Thomas Drlg. Co., Inc.
Address P. O. Box 400, Duncan, OK 73533

STATE OF Kansas COUNTY OF Sedgwick ss.
J. Corry Tinsmon (employee of owner) or (owner or operator) of the above-described

well, being first duly sworn on oath, says: That I have knowledge of the facts, statements, and matters herein contained and the log of the above-described well as filed and that the same are true and correct. So help me God.

(Signature) J. Corry Tinsmon

812 Union Center, Wichita, KS 67202
(Address)

Subscribed and sworn to before me this 13th day of October, 1972

My commission expires December 1, 1972

Eva Jean Burrig, Notary Public.



RECEIVED
STATE CORPORATION COMMISSION
OCT 16 1972
CONSERVATION DIVISION
Wichita, Kansas

MACK OIL COMPANY
Duncan, Oklahoma
73533

DRILLERS WELL LOG


#1 Gus 100' SE C SE NW - Section 15-21S-22W
Hodgeman County, Kansas
Commenced R.D. 10-5-72 Elevation: 2247' K.B.; 2240' G.L.
Completed R.D. 10-12-72 Dry & Abandoned
Rotary Total Depth: 4450' Contractor: Thomas Drlg. Co., Inc.

STRATA	DEPTH
Post Rock & Shale	0 - 315
Shale & Shells	315 - 1115
Shale	1115 - 1436
Anhydrite	1436 - 1500
Shale	1500 - 2180
Shale & Lime	2180 - 2495
Lime	2495 - 2790
Lime & Shale	2790 - 3025
Lime	3025 - 4450 RTD

I hereby certify that the above is a true and correct log of said well as reflected by the daily drilling reports.

MACK OIL COMPANY

BY J. Corry Tinsmon
J. Corry Tinsmon

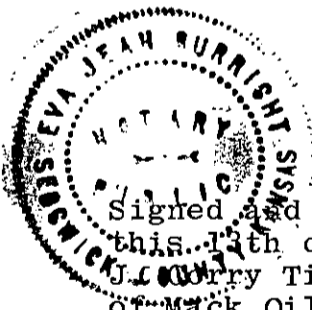

Signed and sworn to in my presence
this 13th day of October, 1972, by
J. Corry Tinsmon, representative
of Mack Oil Company.....

Eva Jean Burright
Eva Jean Burright, Notary Public

My commission expires:
December 1, 1972