

STATE OF KANSAS
STATE CORPORATION COMMISSION

WELL PLUGGING RECORD

Give All Information Completely
Make Required Affidavit
Mail or Deliver Report to:
Conservation Division
State Corporation Commission
211 No. Broadway
Wichita, Kansas

Hodgeman County, Sec. 10 Twp. 21S Rge. 22W (E) (W)

Location as "NE/CNW/SW" or footage from lines C NE NE

Lease Owner Sunray Mid-Continent Oil Company

Lease Name Beulah Hoagland Well No. 1

Office Address 321 West Douglas Wichita, Kansas

Character of Well (completed as Oil, Gas or Dry Hole) Dry Hole

Date well completed October 29 1961

Application for plugging filed October 30 1961

Application for plugging approved October 31 1961

Plugging commenced October 29 1961


Plugging completed October 29 3: P.M. 1961

Reason for abandonment of well or producing formation

Dry Hole

If a producing well is abandoned, date of last production None 19

Was permission obtained from the Conservation Division or its agents before plugging was commenced? Yes

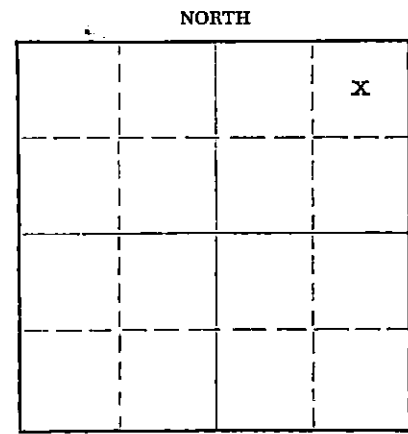

Locate well correctly on above Section Plat

Name of Conservation Agent who supervised plugging of this well W. L. LaKamp

Producing formation None Depth to top Bottom Total Depth of Well 4730 Feet

Show depth and thickness of all water, oil and gas formations.

OIL, GAS OR WATER RECORDS

CASING RECORD

FORMATION	CONTENT	FROM	TO	SIZE	PUT IN	PULLED OUT
Mississippi	Dry	4318	4391	9-5/8"	262'	0
Kinderhook	Dry	4394	4404			
Viola	Dry	4451	4482			
Arbuckle	Water	4626	TD			

Describe in detail the manner in which the well was plugged, indicating where the mud fluid was placed and the method or methods used in introducing it into the hole. If cement or other plugs were used, state the character of same and depth placed, from feet to feet for each plug set.

Filled hole w/ mud and set 20 sack cement plug @ 250'. Filled hole with mud and set 10 sack cmt plug @ 40'. Filled with mud and set 10 sack cement plug @ surface.

RECEIVED
STATE CORPORATION COMMISSION

NOV 9 1961

CONSERVATION DIVISION
Wichita, Kansas

11-9-61

(If additional description is necessary, use BACK of this sheet)

Name of Plugging Contractor Garvey Drilling Company

Address Wichita, Kansas

STATE OF Kansas, COUNTY OF Sedgwick, ss.

Nash A. Gough (employee of owner) of the above-described well, being first duly sworn on oath, says: That I have knowledge of the facts, statements, and matters herein contained and the log of the above-described well as filed and that the same are true and correct. So help me God.

(Signature) Nash A. Gough

321 W. Douglas - Wichita, Kansas (Address)

SUBSCRIBED AND SWORN TO before me this 9th day of November, 1961

Notary Public signature

My commission expires July 13, 1963



WELL LOG BUREAU—KANSAS GEOLOGICAL SOCIETY

508 East Murdock,

Wichita, Kansas

Company. SUNRAY MID-CONTINENT OIL CO.
Farm. Hagland Estate No. 1SEC. 10 T. 21 R. 22W
C NE NE

Total Depth. 4730'


Comm. 10-10-61

Comp. 10-29-61

Shot or Treated.

Contractor. Garvey Drlg. Co.

Issued. 3-10-62

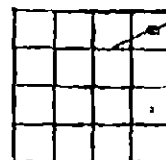County Hodgeman
KANSASCASING:
9 5/8" 262' cem w/175 sx.

Elevation. 2189' RB

Production. Dry

Figures Indicate Bottom of Formations.

blue shale	262
shale & red bed	720
Anhydrite	732
shale	805
sand	1020
shale	1075
sand & shale	1350
Anhydrite	1383
shale	1935
shale & lime	2335
lime	2650
shale & lime	3010
shale	3390
shale & lime	3500
lime & shale	3575
shale & lime	3665
lime	4318
chert	4335
lime & chert	4368
chert	4397
lime	4445
lime & chalk	4490
lime	4515
chert & lime	4531
dolomite & chert	4548
lime & chert	4585
chert & lime	4637
lime & chert	4685
lime	4718
Granite Wash	4730
Total Depth	

TOPS:

Kansas City	3715
Mississippian	4318
Viola	4451

TOPS: SCOUT

Heebner	3670
Toronto	3693
Douglas	3704
Lansing	3725
Base Kansas City	4010
Marmaton	4079
Fort Scott	4156
Cherokee Shale	4220
Morrow	4297
Osage	4336
Kinderhook	4403
Viola	4482
Arbuckle	4626