

STATE OF KANSAS
STATE CORPORATION COMMISSION


Form CP-4

WELL PLUGGING RECORD

Give All Information Completely
Make Required Affidavit
Mail or Deliver Report to:
Conservation Division
State Corporation Commission
211 No. Broadway
Wichita, Kansas

Hodgeman County, Sec. 32 Twp. 21 Rge. (E) 22W
Location as "NE/CNW/SW" or footage from lines C SW NE
Lease Owner James Hershberger
Lease Name Salmons Well No. 1 A
Office Address 1039 First Nat'l Bank Bldg., Wichita, Kansas
Character of Well (completed as Oil, Gas or Dry Hole) Dry
Date well completed 1/26 1964
Application for plugging filed 1/26 1964
Application for plugging approved 1/26 1964
Plugging commenced 8 A.M. 1/26 1964
Plugging completed 2 P.M. 1/26 1964
Reason for abandonment of well or producing formation Dry

NORTH

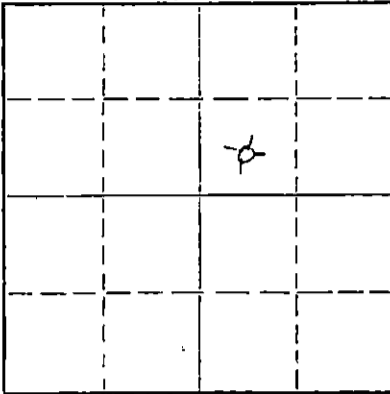

Locate well correctly on above
Section Plat

If a producing well is abandoned, date of last production _____ 19____
Was permission obtained from the Conservation Division or its agents before plugging was commenced? yes

Name of Conservation Agent who supervised plugging of this well Mr. Hugh Scott
Producing formation Dry hole Depth to top _____ Bottom _____ Total Depth of Well _____ Feet
Show depth and thickness of all water, oil and gas formations.

OIL, GAS OR WATER RECORDS

CASING RECORD

FORMATION	CONTENT	FROM	TO	SIZE	PUT IN	PULLED OUT
Lansing	Water	3888	4266	8 5/8"	277'	
Des Moines	Water (tite)	4266	4511			
Mississippian	Water (tite)	4511	4650			

Describe in detail the manner in which the well was plugged, indicating where the mud fluid was placed and the method or methods used in introducing it into the hole. If cement or other plugs were used, state the character of same and depth placed, from _____ feet to _____ feet for each plug set.

Mud to 200' Cement Plug at 700' Pumped in 25 Sax with Sun Cementing
Mud to 270' Cement Plug at 270' Pumped in 25 Sax " " "
Mud to 40' Cement Plug at 40' Pu,ped in 15 sax plus hulls with Sun Cementing

RECEIVED
STATE CORPORATION COMMISSION

FEB 10 1964
2-10-64
CONSERVATION DIVISION
Wichita, Kansas

(If additional description is necessary, use BACK of this sheet)
Name of Plugging Contractor Rotary Hole
Address _____

STATE OF FLORIDA COUNTY OF DADE, ss.
Mrs. Joseph Teichman (employee of owner) or (owner or operator) of the above-described well, being first duly sworn on oath, says: That I have knowledge of the facts, statements, and matters herein contained and the log of the above-described well as filed and that the same are true and correct. So help me God.

(Signature) Joseph Teichman
6045 Pine Tree Drive, Miami Beach, Fla.
(Address)

SUBSCRIBED AND SWORN to before me this 4th day of February, 19 64

My commission expires _____
NOTARY PUBLIC STATE OF FLORIDA at LARGE
MY COMMISSION EXPIRES JUNE 3, 1966
BONDED THROUGH FRED W. DIESTELHORST

Notary Public.

SHOLOM DRILLING COMPANY, INC.
6045 Pine Tree Drive
Miami Beach, Florida

COMPANY: James J. Hershberger, Jr.
FARM: Salmans A
LOCATION: C SW NE Sec 32 T21S R22W, Hodgeman County, Kansas
ROTARY DRILLING CONTRACTOR: Sholom Drilling Co., Inc.

COMMENCED: 1/15/64
COMPLETED: 1/25/64
I. P. : D & A

Elevation: 2249 KB
Rotary T. D.: 4650'
Log T. D.: 4648'

Casing Record:
8 5/8" @ 277' W/175 sax

LOG

- 0 - 40 Clay
- 40 - 75 Sand
- 75 - 255 Shale, shells and sand
- 255 - 590 Shale and shells
- 590 - 795 Red bed, shale and shells
- 795 - 810 Anhydrite
- 810 - 905 Red bed, shale and shells
- 905 - 1095 Sand
- 1095 - 1275 Red bed and shale
- 1275 - 1375 Shale and shells
- 1375 - 1414 Anhydrite
- 1414 - 2605 Lime & shale
- 2605 - 2800 Lime
- 2800 - 3890 Lime and shale
- 3890 - 4415 Lime
- 4415 - 4518 Lime and shale
- 4518 - 4562 Lime, shale and sand
- 4562 - 4625 Shale and lime
- 4625 - 4650 Shale, lime and chert

No Tests.

Log: Welox at T. D.


RECEIVED
STATE CORPORATION COMMISSION
FEB 10 1964
CONSERVATION DIVISION
Wichita, Kansas

STATE OF FLORIDA)
) ss
COUNTY OF DADE)

I, Joseph Teichman, President of Sholom Drilling Company, Inc., a corporation of the State of Oklahoma, domesticated in the State of Kansas, being first duly sworn under oath, says: That I have knowledge of the facts, statements and matters herein contained of the above described well as filed and that the same are true and correct.


Joseph Teichman

Subscribed and sworn to before me this 6th day of February, 1964

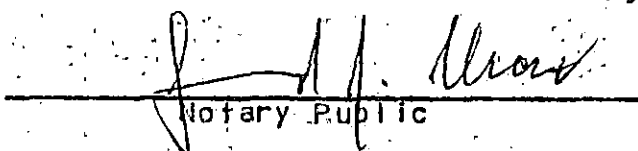
Notary Public

My Commission expires: _____