

STATE OF KANSAS  
STATE CORPORATION COMMISSION

Form CP-4

Give All Information Completely  
Make Required Affidavit  
Mail or Deliver Report to:  
Conservation Division  
State Corporation Commission  
P. O. Box 17027  
Wichita, Kansas 67217  
NORTH

WELL PLUGGING RECORD

Hodgeman County, Sec. 32 Twp. 21S Rge. (E) 22 (W)

Location as "NE/CNW/SW" or footage from lines C-SW-SW

Lease Owner O. A. Sutton

Lease Name Hamilton Well No. 1

Office Address 800 Sutton Place Wichita, Kansas 67202

Character of Well (completed as Oil, Gas or Dry Hole) Dry Hole

Date well completed August 16 19 74

Application for plugging filed August 16 19 74

Application for plugging approved August 16 19 74


Plugging commenced August 16 19 74

Plugging completed August 16 19 74

Reason for abandonment of well or producing formation

If a producing well is abandoned, date of last production 19

Was permission obtained from the Conservation Division or its agents before plugging was commenced?

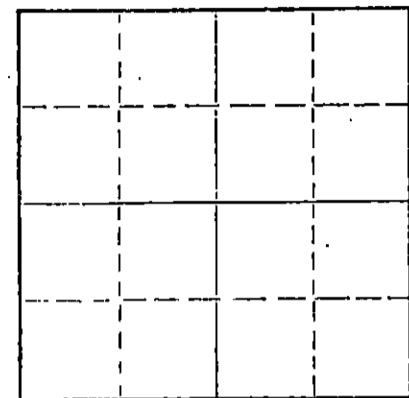

Locate well correctly on above Section Plat

Name of Conservation Agent who supervised plugging of this well Edgar Eyes

Producing formation Depth to top Bottom Total Depth of Well 4516 Feet

Show depth and thickness of all water, oil and gas formations.

OIL, GAS OR WATER RECORDS

CASING RECORD

FORMATION	CONTENT	FROM	TO	SIZE	PUT IN	PULLED OUT
Surface Clay-Sand-Shale						
Sand-Redbed-Blane Gyp		0	780	8 5/8		

Describe in detail the manner in which the well was plugged, indicating where the mud fluid was placed and the method or methods used in introducing it into the hole. If cement or other plugs were used, state the character of same and depth placed, from feet to feet for each plug set.

1st Plug @ 850' w/80 sax  
336' w/80 sax  
45 w/80 sax  
Bridge Rat Hole w/15 sax

RECEIVED 8-30-74  
STATE CORPORATION COMMISSION  
AUG 30 1974  
CONSERVATION DIVISION  
Wichita, Kansas

(If additional description is necessary, use BACK of this sheet)

Name of Plugging Contractor Gabbert-Jones

Address 830 Sutton Place Wichita, Ks. 67202

STATE OF Kansas, COUNTY OF Sedgwick, ss.


(employee of owner) or (owner or operator) of the above-described well, being first duly sworn on oath, says: That I have knowledge of the facts, statements, and matters herein contained and the log of the above-described well as filed and that the same are true and correct. So help me God.

(Signature) *James J. Sutton II*

(Address)

Subscribed and Sworn to before me this 28 day of August, 1974

Marjorie Hall Notary Public.

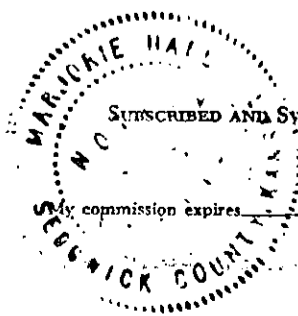

GABBERT-JONES, INC.  
WICHITA, KANSAS  
DRILLERS' WELL LOG

RECEIVED  
STATE CORPORATION COMMISSION  
AUG 30 1974  
CONSERVATION DIVISION  
Wichita, Kansas

Hamilton #1  
C-SW-SW Sec 32-21S-22W  
Hodgeman County Kansas

Commenced: 8-2-74

Completed: 8-16-74

OPERATOR: O. A. SUTTON

Depth		Formation	Remarks
From	to		
360	360	Surface Clay-Sand-Shale	Ran 9 jts of 8 5/8" 28#
360	768	Shale-Sand-Redbed	Csg set @ 356' Cemented
768	780	Blane Gyp	w/225 sks Comman 2% Gel
780	1447	Shale-Redbed-Sand	2% CC PD @11:15 p.m. 8-3-74
1447	1845	Shale-Redbed	Cement Circ
1845	2310	Shale	
2310	2425	Shale-Lime	
2425	3995	Lime-Shale	
3995	4025	Lime	
4025	4200	Lime-Shale	
4200	4516	Lime	
	4516 TD		DRY & ABANDONED

I, James S. Sutton II, certify this is a correct copy of the Drillers' Log for the well drilled C-SW-SW Sec 32-21S-22W Hodgeman County Kansas to the best of my knowledge and belief.

*James S. Sutton II*  
JAMES S. SUTTON II

STATE OF KANSAS )  
                          ) SS  
COUNTY OF SEDGWICK)

Before me, the undersigned, a Notary Public within and for said County and State, on this 28th day of August, 1974 personally appeared James S. Sutton II to me personally known to be the identical person who executed the within and foregoing instrument and acknowledged to me that he executed the same as his free and voluntary act and deed for the uses and purposes therein set forth.

IN WITNESS WHEREOF, I have hereunto set my hand and official seal the day and year last above written.

*Marjorie Hall*  
MARJORIE HALL-NOTARY PUBLIC

Commission Expires: November 29th, 1975.

