


STATE OF KANSAS
STATE CORPORATION COMMISSION

Give All Information Completely
Make Required Affidavit
Mail or Deliver Report to:
Conservation Division
State Corporation Commission
300 Bittling Building
Wichita, Kansas

WELL PLUGGING RECORD

NORTH

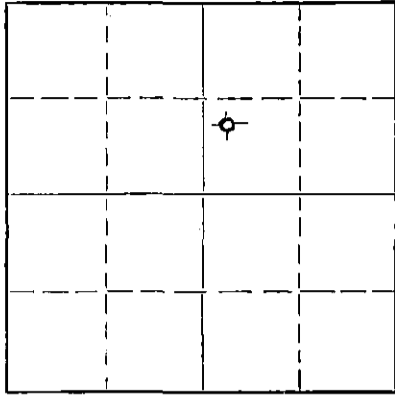

Locate well correctly on above
Section Plat

Hodgeman County. Sec. 30 Twp. 21S Rge. 22W (E) (W)
Location as "NE/CNW/SW" or footage from lines NW SW NE
Lease Owner Imperial Drilling Company, Inc.
Lease Name Hendrickson Well No. 1
Office Address 903 Union National Bank Building, Wichita, Kansas
Character of Well (completed as Oil, Gas or Dry Hole) Dry Hole
Date well completed February 6 19 53
Application for plugging filed February 6 19 53
Application for plugging approved February 6 19 53
Plugging commenced 1:00 a.m., February 6 19 53
Plugging completed 8:00 a.m., February 6 19 53
Reason for abandonment of well or producing formation Commercial quantity of oil not found
If a producing well is abandoned, date of last production 19
Was permission obtained from the Conservation Division or its agents before plugging was commenced? Yes

Name of Conservation Agent who supervised plugging of this well C. D. Stough
Producing formation _____ Depth to top _____ Bottom _____ Total Depth of Well 4605 Feet
Show depth and thickness of all water, oil and gas formations.

OIL, GAS OR WATER RECORDS

CASING RECORD

FORMATION	CONTENT	FROM	TO	SIZE	PUT IN	PULLED OUT
				8 5/8"	480'	

Describe in detail the manner in which the well was plugged, indicating where the mud fluid was placed and the method or methods used in introducing it into the hole. If cement or other plugs were used, state the character of same and depth placed, from _____ feet to _____ feet for each plug set.

Set bottom plug at 390' with 20 sacks. Top plug set at 40' with 10 sacks

2-12-53

(If additional description is necessary, use BACK of this sheet)

Name of Plugging Contractor Deek Drilling, Inc.
Address 1006 Central Building, Wichita, Kansas

STATE OF Kansas, COUNTY OF Sedgwick, ss.
Clinton Engstrand, agent for ~~employee of owner~~ (owner or operator) of the above described well, being first duly sworn on oath, says: That I have knowledge of the facts, statements, and matters herein contained and the log of the above-described well as filed and that the same are true and correct. So help me God.

(Signature) *Clinton Engstrand*
1006 Central Building
(Address)

SUBSCRIBED AND SWORN to before me this 10 day of February, 19 53

Waldemar Rogers
Notary Public.

My commission expires October 29, 1955

