


STATE OF KANSAS
STATE CORPORATION COMMISSION

Form CP-4

WELL PLUGGING RECORD

Give All Information Completely
Make Required Affidavit
Mail or Deliver Report to:
Conservation Division
State Corporation Commission
212 No. Market
Wichita, Kansas

NORTH

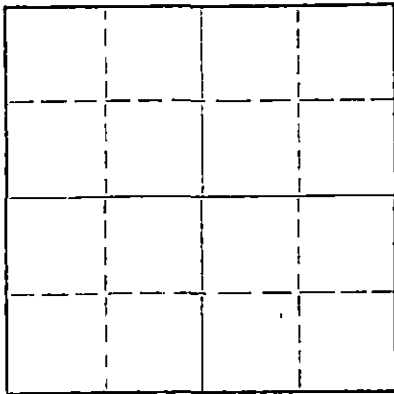

Locate well correctly on above
Section Plat

Hodgeman County. Sec. 29 Twp. 21S Rge. (E) 22 (W)
Location as "NE/CNW&SW&" or footage from lines C SE NW

Lease Owner O. A. Sutton
Lease Name Halling Well No. 1
Office Address 800 Sutton Place, Wichita, Kansas
Character of Well (completed as Oil, Gas or Dry Hole) Dry Hole
Date well completed June 8 1968
Application for plugging filed June 8 1968
Application for plugging approved June 8 1968
Plugging commenced June 8 1968
Plugging completed June 8 1968
Reason for abandonment of well or producing formation _____

If a producing well is abandoned, date of last production _____ 19____
Was permission obtained from the Conservation Division or its agents before plugging was commenced? Yes

Name of Conservation Agent who supervised plugging of this well Edgar Eves
Producing formation _____ Depth to top _____ Bottom _____ Total Depth of Well 4488 Feet
Show depth and thickness of all water, oil and gas formations.

OIL, GAS OR WATER RECORDS

CASING RECORD

FORMATION	CONTENT	FROM	TO	SIZE	PUT IN	PULLED OUT
				8 5/8"	283'	

Describe in detail the manner in which the well was plugged, indicating where the mud fluid was placed and the method or methods used in introducing it into the hole. If cement or other plugs were used, state the character of same and depth placed, from _____ feet to _____ feet for each plug set.

1st plug @ 1100', 100 sacks cement. Mud up to 300'. Plug 300' to 200' with 30 sacks cement. 3rd plug @ 45' with 15 sacks cement. Job complete at 5:45 p.m. by Halliburton.

12-13-68
RECEIVED
STATE CORPORATION COMMISSION
JUN 13 1968
CONSERVATION DIVISION
Wichita, Kansas

(If additional description is necessary, use BACK of this sheet)

Name of Plugging Contractor Gabbert-Jones Inc.
Address 830 Sutton Place, Wichita, Kansas

STATE OF KANSAS, COUNTY OF SEDGWICK, ss.
Jack G. Paulsen (employee of owner) or ~~(owner or operator)~~ of the above-described well, being first duly sworn on oath, says: That I have knowledge of the facts, statements, and matters herein contained and the log of the above described well as filed and that the same are true and correct. So help me God.

(Signature) Jack G. Paulsen
800 Sutton Place, Wichita, Kansas
(Address)

SUBSCRIBED AND SWORN to before me this 12th day of June 1968.
Jean S. Taylor Notary Public.

My commission expires June 28, 1968.

