


STATE OF KANSAS
STATE CORPORATION COMMISSION

WELL PLUGGING RECORD

Give All Information Completely
Make Required Affidavit
Mail or Deliver Report to
Conservation Division
State Corporation Comm.
245 North Water
Wichita, KS 67202

Hodgeman County, Sec. 29 Twp. 21 Rge. 22 EW
Location as "NE/CNW $\frac{1}{2}$ SW $\frac{1}{2}$ " or footage from lines
C NW NW

Lease Owner Brooks Hall Oil Corporation
Lease Name Halling Well No. 1
Office Address 101 Park Avenue, Suite 600, O.C.O. 73102
Character of Well (Completed as Oil, Gas or Dry Hole)
Dry Hole

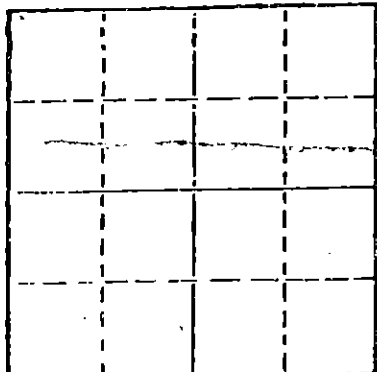

Locate well correctly on above
Section Plot

Date Well completed 12/29/78 19
Application for plugging filed 12/29/78 19
Application for plugging approved 12/29/78 19
Plugging commenced 12/29/78 19
Plugging completed 12/29/78 19
Reason for abandonment of well or producing formation

If a producing well is abandoned, date of last production 19

Was permission obtained from the Conservation Division or its agents before plugging was commenced? yes

Name of Conservation Agent who supervised plugging of this well Clarence Thomas
Producing formation Depth to top Bottom Total Depth of Well

Show depth and thickness of all water, oil and gas formations.

OIL, GAS OR WATER RECORDS

CASING RECORD

FORMATION	CONTENT	FROM	TO	SIZE	PUT IN	PULLED OUT
	Surface	0	316	8-5/8	yes	no

Describe in detail the manner in which the well was plugged, indicating where the mud fluid was placed and the method or methods used in introducing it into the hold. If cement or other plugs were used, state the character of same and depth placed, from _____ feet to _____ feet for each plug set.

Bottom plug at 900' with 50 sacks 50/50 Poz
Second plug at 320' with 35 sacks 50/50 Poz
Solid bridge at 40' with 10 sacks 50/50 Poz
5 sacks in rathole

1-9-79

Job complete @ 12:30 p.m. 12/29/78

STATE RECEIVED
STATE CORPORATION COMMISSION

JAN - 9 1979

CONSERVATION DIVISION
STATE OF KANSAS

(If additional description is necessary, use BACK of this sheet)

Name of Plugging Contractor Slawson Drilling Company, Inc.

STATE OF Kansas COUNTY OF Sedgwick, ss.

James C. Remsberg (employee of owner) or (owner or operator)
of the above-described well, being first duly sworn on oath, says: That I have knowledge of the facts, statements, and matters herein contained and the log of the above-described well as filed and that the same are true and correct. So help me God.


(Signature)

James C. Remsberg
James C. Remsberg
200 Douglas Building, Wichita, Ks. 67202
(Address)

SUBSCRIBED AND SWORN TO before me this 8 day of January, 1979

Mary Lou Taylor
Mary Lou Taylor Notary Public.

My commission expires January 17, 1981

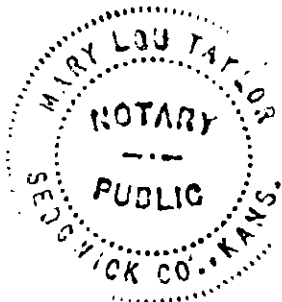

DRILLERS LOG

OPERATOR: Brooks Hall Oil Corporation
 101 Park Avenue, Suite 600
 Oklahoma City, Oklahoma 73102

LEASE: Halling No. 1
 C NW NW Sec. 29-21S-22W
 Hodgeman County, Kansas

CONTRACTOR: Slawson Drilling Company, Inc.
 200 Douglas Building
 Wichita, Kansas 67202

COMMENCED: 12/18/78

COMPLETED: 12/29/78

RTD: 4530'

SURFACE CASING: 8-5/8" set at 311' with 210 sx cement

0' to 316' 12 1/4" Surface Hole
 316' to 1895' Shale & Shells
 1895' to 2552' Shale & Lime
 2552' to 2590' Lime & Shale
 2590' to 3200' Shale & Lime
 3200' to 3520' Lime & Shale
 3520' to 3712' Shale & Lime
 3712' to 3892' Lime & Shale
 3892' to 4150' Shale & Lime
 4150' to 4282' Lime & Shale
 4282' to 4370' Shale & Lime
 4370' to 4490' Lime & Shale
 4490' to 4530' Shale & Lime
 4530' RTD

STATE OF KANSAS

COUNTY OF SEDGWICK

I, James C. Remsberg, of the Slawson Drilling Company, Inc. hereby state that the above is an accurate copy of the Halling No. 1 log for Brooks Hall Oil Corporation.

James C. Remsberg
 James C. Remsberg

Subscribed and sworn to me this 8th day of January, 1979.

Mary Lou Taylor
 Mary Lou Taylor Notary

RECEIVED
 STATE COMMISSION

JAN - 9 1979

My commission expires January 17, 1981

COMMISSION EXPIRES
 JAN 17 1981

