

STATE OF KANSAS
STATE CORPORATION COMMISSION

WELL PLUGGING RECORD

Give All Information Completely
Make Required Affidavit
Mail or Deliver Report to:
Conservation Division
State Corporation Commission
212 No. Market
Wichita, Kansas

Pawnee

County. Sec. 1 Twp. 21 S Rge. 16 W (E) (W)

Location as "NE/CNW/SW" or footage from lines NW SE SW

Lease Owner ALPINE OIL & ROYALTY CO., INC.

Lease Name Barrett Well No. 4

Office Address 800 Bitting Building, Wichita, Kansas

Character of Well (completed as Oil, Gas or Dry Hole) oil well

Date well completed January 10, 1964 19

Application for plugging filed February 3, 1966 19

Application for plugging approved February 4, 1966 19


Plugging commenced February 17, 1966 19

Plugging completed February 19, 1966 19

Reason for abandonment of well or producing formation non-productive in commercial quantities

If a producing well is abandoned, date of last production February 7 19 66

Was permission obtained from the Conservation Division or its agents before plugging was commenced? yes

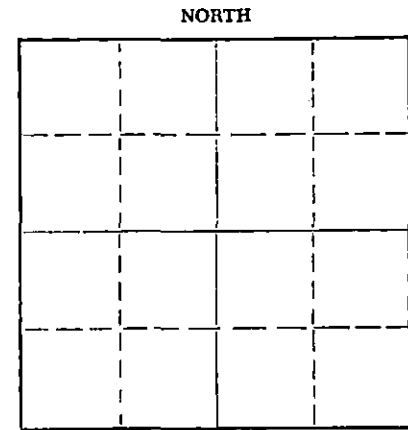

Locate well correctly on above Section Plat

Name of Conservation Agent who supervised plugging of this well Gilbert Leiker

Producing formation Arbuckle Depth to top 3777 Bottom Total Depth of Well 3796 Feet

Show depth and thickness of all water, oil and gas formations.

OIL, GAS OR WATER RECORDS

CASING RECORD

FORMATION	CONTENT	FROM	TO	SIZE	PUT IN	PULLED OUT
				8 5/8"	986'	cemented
				5 1/2"	3779	3034'

Describe in detail the manner in which the well was plugged, indicating where the mud fluid was placed and the method or methods used in introducing it into the hole. If cement or other plugs were used, state the character of same and depth placed, from feet to feet for each plug set.

Sand from 3796 feet to 3770 feet. Ran 3 sacks of cement from 3770 feet to 3750 feet. Heavy mud from 3750 feet to 480 feet
Rock bridge from 480 feet to 470 feet. Ran 25 sacks of cement from 470 feet to 395 feet. Heavy mud from 395 feet to 40 feet. Rock bridge and 10 sacks of cement to base of cellar.

RECEIVED
STATE CORPORATION COMMISSION

3-7-66

MAR 7 1966

CONSERVATION DIVISION
WICHITA, KANSAS

(If additional description is necessary, use BACK of this sheet)

Name of Plugging Contractor Glenn and Smith Pipe Pulling Company

Address Box 156, Ellinwood, Kansas

STATE OF Kansas COUNTY OF Sedgwick, ss.

Dwight J. Wilson (employee of owner) or (owner or operator) of the above-described well, being first duly sworn on oath, says: That I have knowledge of the facts, statements, and matters herein contained and the log of the above-described well as filed and that the same are true and correct. So help me God.

(Signature)

800 Bitting Building, Wichita, Kansas (Address)

SUBSCRIBED AND SWORN TO before me this 7th day of March, 19 66

My commission expires August 10, 1969

Virginia Mundell

Notary Public.

WELL LOG

ALPINE OIL & ROYALTY CO., INC.

Commenced: December 20, 1963

CONTRACTOR: Quaker Drilling Co., Inc.

Completed: January 1, 1964

Barrett No. 4
NW SE SW Sec. 1-215-16W
Pawnee County, Kansas

Elevations: 1970 K. B.

Casing Record:

8 5/8ths inch casing set at 986 feet with 475 sacks cement
5 1/2 inch casing set at 3779 feet with 100 sacks cement

(The Figures Indicate the Bottom of the Formations)

<u>FORMATION</u>	<u>DEPTH</u>	<u>FORMATION TOPS</u>	
Surface Soil, Sand	395	Heebner	3318 - 1347
Dakota Sand	505	Brown Lime	3409 - 1438
Shale	555	Lansing-Kansas City	3419 - 1448
Red Bed	750	Base of Kansas City	3665 - 1694
Shale and Shells	971	Viola	3688 - 1717
Anhydrite	986	Simpson Shale	3744 - 1773
Shale and Lime	3295	Arbuckle	3777 - 1806
Lime	3350	Rotary Total Depth	3785 - 1814
Lime and Shale	3710		
Cherty Lime and Shale	3750		
Lime and Shale	3785		

RECEIVED
STATE CORPORATION COMMISSION
FEB 4 1966
CONSERVATION DIVISION
Wichita, Kansas

We hereby certify the foregoing to be a true and correct copy of the driller's log of the well drilled in the NW SE SW of Section 1, Township 21 South, Range 16 West, Pawnee County, Kansas.

QUAKER DRILLING CO., INC.

By: *William Dennis*

SUBSCRIBED AND SWORN TO BEFORE ME this 4th day of January, 1964.

Virginia Mundell
Virginia Mundell, Notary Public

MY COMMISSION EXPIRES:
August 10, 1965