


WELL PLUGGING RECORD

Give All Information Completely
Make Required Affidavit
Mail or Deliver Report
Conservation Division
State Corporation Commission
800 Bittling Building
Wichita, Kansas

Pawnee County. Sec. 1 Twp. 21 Rge. 16 (E) (W)
Location as "NE/CNW $\frac{1}{4}$ /SW $\frac{1}{4}$ " or footage from lines SE NE SW
Lease Owner BEN F. BRACK OIL COMPANY, INC.
Lease Name BARRETT Well No. 1
Office Address 309 Brown Building, Wichita 2, Kansas
Character of Well (completed as Oil, Gas or Dry Hole) Oil
Date well completed 2-1-49 19
Application for plugging filed 1-10-51 19
Application for plugging approved 1-10-51 19
Plugging commenced 1-10-51 19
Plugging completed 1-10-51 19
Reason for abandonment of well or producing formation nothing there

NORTH

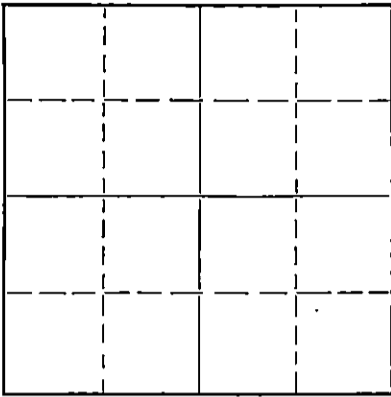

Locate well correctly on above
Section Plat

If a producing well is abandoned, date of last production December 30 1950
Was permission obtained from the Conservation Division or its agents before plugging was commenced? Yes - Orally

Name of Conservation Agent who supervised plugging of this well Mr. C. D. Stough
Producing formation Arbuckle Depth to top 3780 Bottom 3786 Total Depth of Well 3786 Feet
Show depth and thickness of all water, oil and gas formations.

OIL, GAS OR WATER RECORDS

CASING RECORD

Formation	Content	From	To	Size	Put In	Pulled Out
Sub-Soil, Gravel & Shale	280'	0	280'	8 5/8"	585'	3287'
Arbuckle		3780	3786	5 1/2"	3781'	

Describe in detail the manner in which the well was plugged, indicating where the mud fluid was placed and the method or methods used in introducing it into the hole. If cement or other plugs were used, state the character of same and depth placed, from 510' to 30' feet for each plug set.

Filled with heavy mud to 585'
Pumped 175 sacks bulk cement down surface casing to shut off water flow by Halliburton process.
Filled with mud to 30'
Set top plug with 5 sacks cement.

1-19-51

JAN 19 1951
CONSERVATION DIVISION
WICHITA, KANSAS

(If additional description is necessary, use BACK of this sheet)

Correspondence regarding this well should be addressed to BEN F. BRACK OIL COMPANY, INC.
Address 309-10 BROWN BUILDING
WICHITA 2, KANSAS

STATE OF KANSAS, COUNTY OF SEDGWICK, ss.
Emil E. Bowers (employee of owner) or (owner or operator) of the above-described well,
being first duly sworn on oath, says: That I have knowledge of the facts, statements, and matters herein contained and the log of the above-described well as filed and that the same are true and correct. So help me God.

(Signature) Emil E. Bowers
BEN F. BRACK OIL COMPANY, INC.
309-10 Brown Building Wichita 2, Kansas

SUBSCRIBED AND SWORN to before me this 18th day of January, 1951.

Uelred R. [Signature]
Notary Public.

My commission expires November 1, 1954

PLUGGING
FILE SEC LT 2 R 16
BOOK PAGE 54 LINE 24

PLUGGING
 SEC 1 T 21 N 16 W
 BOOK PAGE SKELINE 22

By: *[Signature]*
 BEN F. BRACK OIL COMPANY, INC.

To the best of my knowledge the above is a true and correct record of the formations and depths at which found.

Witness: *[Signature]*
 Dated: 2-3-49

CONSOLIDATED STATE CORPORATION
 JAN 19 1951
 (Top Brown Lime @ 3411)
 (Top Limestone @ 3425)
 (Top Arbuckle 3780' (-131))

3786	Cellar
280	Sub Soil, Sand, Gravel & Shale
400	Shale, Shells & Sand
510	Dakota Sand
565	Red Bed, Shale & Shells
585	Red Bed & Shale
610	Red Bed, Sand
755	Red Bed
935	Red Bed with streaks Sand
945	Shale & Shells
960	Anhydrite
1235	Shale & Shells
1490	Shale, Shells & Salt
1650	Salt & Shells
1725	Shale & Shells
1870	Lime
1995	Lime & Shale
2110	Lime & Shale
2165	Lime
2250	Lime and Shale
2345	Lime & Shale
2430	Lime & Shale Streaks
2465	Lime & Shale
2570	Lime & Shale
2690	Lime & Shale
2830	Lime & Shale
2915	Lime & Shale
3000	Lime & Shale
3070	Lime & Shale
3165	Broken Lime
3215	Lime & Shale Streaks
3260	Lime & Shale
3320	Lime
3385	Lime & Shale
3434	Lime & Shale
3464	Lime
3485	Lime
3547	Lime & Shale
3564	Lime
3625	Lime
3685	Lime & Shale
3738	Lime & Chert
3750	Cherty Lime
3760	Lime & Shale
3786	Lime & Shale
3786	TOTAL DEPTH

Comm: 1-13-49 Comp: 2-1-49

WELL LOG

District No. 1 SE NE SW Section 1, T. 21 S., R. 16 W., Pawnee County, Kansas

BEN F. BRACK OIL COMPANY, INC.
 310 Brown Building
 Wichita, Kansas