


WELL PLUGGING RECORD

Give All Information Completely
Make Required Affidavit
Mail or Deliver Report to:
Conservation Division
State Corporation Commission
800 Bittling Building
Wichita, Kansas

NORTH

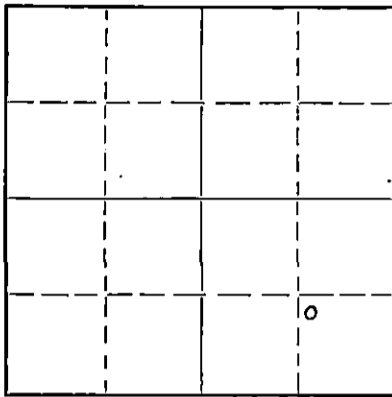

Locate well correctly on above
Section Plat

Pawnee County. Sec. 1 Twp. 21 Rge. 16 ~~25~~ W (W)
Location as "NE/CNW $\frac{1}{4}$ SW $\frac{1}{4}$ " or footage from lines NW SE SE
Lease Owner Ben F. Brack Oil Company, Inc.
Lease Name Smith "B" Well No. 3
Office Address 309-10 Brown Building, Wichita, Kansas
Character of Well (completed as Oil, Gas or Dry Hole) Oil
Date well completed December 21 19 47
Application for plugging filed November 6 19 50
Application for plugging approved November 6 19 50
Plugging commenced November 6 19 50
Plugging completed November 6 19 50
Reason for abandonment of well or producing formation
No longer commercial production
If a producing well is abandoned, date of last production June 30 19 48
Was permission obtained from the Conservation Division or its agents before plugging was commenced? Yes

Name of Conservation Agent who supervised plugging of this well C. D. Stough
Producing formation Arbuckle Depth to top 3775 Bottom 3780 Total Depth of Well 3780 Feet
Show depth and thickness of all water, oil and gas formations.

OIL, GAS OR WATER RECORDS

CASING RECORD

Formation	Content	From	To	Size	Put In	Pulled Out
Sand, Clay and Surface Soil	No Show	0	945	8-5/8"	945	
Arbuckle	Fair Show		3775	5-1/2"	118 jts	2963.05'

Describe in detail the manner in which the well was plugged, indicating where the mud fluid was placed and the method or methods used in introducing it into the hole. If cement or other plugs were used, state the character of same and depth placed, from 250 feet to 30 feet for each plug set.

Pumped 120 sacks cement down surface casing by Halliburton.
Plugged hole with mud to 250 ft, cemented with 15 sacks of cement. Plugged at 30 feet and cemented with 10 sacks of cement. Filled to top.

Instructed and supervised by Mr. C. D. Stough.

11-18-50

STATE CORPORATION COMMISSION
NOV 18 1950
CONSERVATION DIVISION
Wichita, Kansas

(If additional description is necessary, use BACK of this sheet)

Correspondence regarding this well should be addressed to BEN F. BRACK OIL COMPANY, INC.
Address 309-10 Brown Building Wichita, Kansas

STATE OF Kansas, COUNTY OF Sedgwick, ss.
Ben. F. Brack (employee of owner) or (owner or operator) of the above-described well,
being first duly sworn on oath, says: That I have knowledge of the facts, statements, and matters herein contained and the log of the above-described well as filed and that the same are true and correct. So help me God.

(Signature) Ben F. Brack
BEN F. BRACK OIL COMPANY, INC.
309 Brown Building, Wichita, Kansas

SUBSCRIBED AND SWORN to before me this 16th day of November, 19 50

My commission expires October 2, 1953

Luella A. Burdick
Notary Public.

PLUGGING
FILE SEC-1 T 21 R/6W
BOOK PAGE 40 LINE 38

Well
LOG

Smith No. "B" 3

SE/4 of Section 1-21-16-Pawnee County, Kansas

TOTAL DEPTH 3780'

Comm: 12-2-47 Comp: 12-21-47

Cellar	5'
sand & gravel	162
shale & shell	300
shale & shells	385
sand	500
shale, shells & red bed	565
shale & red bed	725
shale, shell & red bed	962
anhydrite	965
anhydrite, shale & shells	1156
red bed, shale & salt	1450
shale & shells	1500
shale & shells	1695
shale & lime	1835
lime & shale	1950
lime	2050
lime	2155
lime	2215
lime	2295
lime	2385
lime	2450
shale & lime	2470
shale & shells	2570
lime & shale	2675
shale & lime, shells	2780
lime & shale	2855
lime & shale	2920
lime & shale	3010
lime & shale	3110
lime	3170
lime & shale	3205
lime & shale	3265
lime & shale	3315
lime	3390
lime	3450
lime	3485
lime	3560
lime	3600
lime	3645
lime	3680
lime & chert	3715
conglomerate	3751
lime, arbutle	3757
lime	3775

TOTAL DEPTH 3780

RECEIVED
STATE CORPORATION COMMISSION
NOV 18 1950
CONSULTING DIVISION
Wichita, Kansas

To the best of my knowledge the above is a true and correct record of the formations and depths at which found.

DATED: 12-23-47

WITNESS: Martine Underwood

BEN F. BRACK OIL COMPANY, INC.

By: B. F. Brack

PLUGGING
FOR SEC-1-T-21-R(62)
PAGE 40 LINE 38