


STATE OF KANSAS
STATE CORPORATION COMMISSION

WELL PLUGGING RECORD

Give All Information Completely
Make Required Affidavit
or Deliver Report to:
Conservation Division
State Corporation Commission
800 Bitting Building
Wichita, Kansas

Pawnee County. Sec. 1 Twp. 21 Rge. 16 (E) (NW)
Location as "NE/CNW $\frac{1}{4}$ /SW $\frac{1}{4}$ " or footage from lines NW NE SE
Lease Owner Ben F. Brack Oil Company, Inc.
Lease Name Smith Well No. 5
Office Address 309 Brown Building, Wichita 2, Kansas
Character of Well (completed as Oil, Gas or Dry Hole) Oil
Date well completed February 23, 1948 19
Application for plugging filed January 22, 1951 19
Application for plugging approved January 22, 1951 19
Plugging commenced January 22, 1951 19
Plugging completed January 22, 1951 19
Reason for abandonment of well or producing formation nothing there

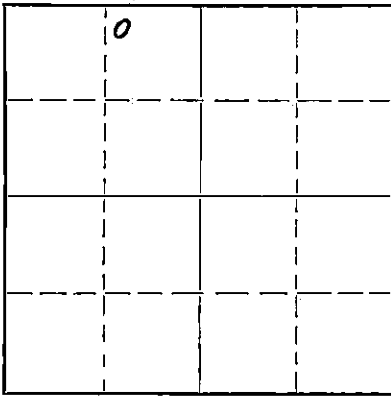

Locate well correctly on above
Section Plat

If a producing well is abandoned, date of last production December 31, 1950
Was permission obtained from the Conservation Division or its agents before plugging was commenced? Yes, Orally

Name of Conservation Agent who supervised plugging of this well Mr. C. D. Stough Box 207 Great Bend, Ks.
Producing formation Arbuckle Depth to top Bottom Total Depth of Well 3762' Feet
Show depth and thickness of all water, oil and gas formations.

OIL, GAS OR WATER RECORDS

CASING RECORD

Formation	Content	From	To	Size	Put In	Pulled Out
Shale, Red Bed, Sand		0	610	8-5/8	735'	
				5-1/2	3779	1962.39'

Describe in detail the manner in which the well was plugged, indicating where the mud fluid was placed and the method or methods used in introducing it into the hole. If cement or other plugs were used, state the character of same and depth placed, from 3770' feet to 20' feet for each plug set.

Plugged back with chat 3770' - 5 sacks of cement. Pumped 200 sacks of cement down to shut off waterflow by Hallibuton Process. Cement settled down about 20' filled up with cement to surface.

RECEIVED
STATE CORPORATION COMMISSION
JAN 30 1951
CONSERVATION DIVISION
Wichita, Kansas

1-30-51

(If additional description is necessary, use BACK of this sheet)

Correspondence regarding this well should be addressed to Ben F. Brack Oil Company, Inc.
Address 309-10 Brown Building, Wichita, Kansas

STATE OF Kansas, COUNTY OF Sedgwick, ss.
Emil E. Bowers (employee of owner) or (owner or operator) of the above-described well,
being first duly sworn on oath, says: That I have knowledge of the facts, statements, and matters herein contained and the log of the above-described well as filed and that the same are true and correct. So help me God. BEN F. BRACK OIL COMPANY, INC.
(Signature) Emil E. Bowers
309-10 Brown Bldg., Wichita 2, Kansas
(Address)

SUBSCRIBED AND SWORN to before me this 26th day of January, 1951
Walter R. Evans
Notary Public.

My commission expires November 1, 1954

PLUGGING
FILE SEC T R
INDEX PAGE LINE

WELL LOG BUREAU -- KANSAS GEOLOGICAL SOCIETY
412 Union National Bank Building, Wichita, Kansas

Company - Ben F. Brack Oil Co., Inc.

Sec. 1 T. 21 R. 16
Loc. NW NE SE

Farm Smith "B" No. 5

County Pawnee

Total Depth 3782'

Comm. 2-5-48 Comp. 2-23-48

Contractor Ben F. Brack Oil Co., Inc.

Cellar	5'
Shale	70
Shale & Red Bed	380
Shale	395
Sand	500
Shale and Shells	550
Sand	610
Red Bed, shale & shells	690
Cement	760
Red Bed	850
Red Sand and Shale	968
Anhydrite	1000
Red Bed	1005
Red Bed, shale and Salt	1335
Red Bed, Sale and Shale	1600
Lime and Shale	1735
Shale & Lime	1830
Lime and Shale	1925
Sand and Lime	2020
Lime	2020
Lime and Shale	2170
Lime	2215
Lime	2300
Lime	2380
Lime and Shale	2435
Lime and Shale	2570
Lime and Shale	2680
Lime and Shale	2790
Lime and Shale	2865
Lime and Shale	2960
Lime and Shale	3055
Lime and Shale	3145
Lime and Shale	3185
Lime	3260
Lime	3310
Lime	3365
Shale and Lime	3415 (top K.C. 3407)
Lime	3440
Lime	3460
Lime	3535
Lime	3580
Lime	3625
Lime	3665
Lime and Shale	3720
Lime	3740
Lime	3775 (top Arbuckle 3748)
5 ft. core	3780
Lime	3781
Lime	3782
Total Depth	3782

RECEIVED
STATE CORPORATION COMMISSION
JAN 30 1951
CONSERVATION DIVISION
Wichita, Kansas

PLUGGING
FILE SEC—T—R—
BOOK PAGE—LINE—