


WELL PLUGGING RECORD

Give All Information Completely
Make Required Affidavit
Mail or Deliver Report to:
Conservation Division
State Corporation Commission
800 Blitting Building
Wichita, Kansas

NORTH

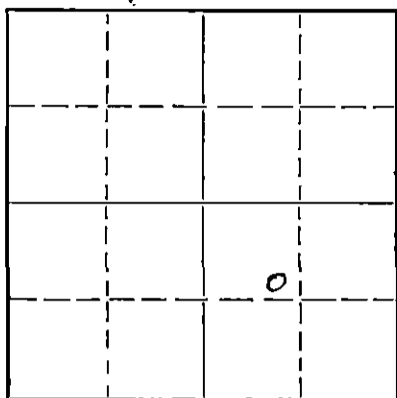

Locate well correctly on above Section Plat

Pawnee County. Sec. 1 Twp. 21 Rge. 16 (E) W. (W)
Location as "NE/CNW $\frac{1}{4}$ SW $\frac{1}{4}$ " or footage from lines SE NW SE
Lease Owner BEN F. BRACK OIL COMPANY, INC.
Lease Name SMITH "B" Well No. 4
Office Address 309 Brown Building Wichita 2, Kansas
Character of Well (completed as Oil, Gas or Dry Hole) Oil
Date well completed February 24, 1948 19
Application for plugging filed March 8, 1951 19
Application for plugging approved March 8, 1951 19
Plugging commenced March 8, 1951 19
Plugging completed March 8, 1951 19
Reason for abandonment of well or producing formation Oil Depleted
If a producing well is abandoned, date of last production March 4, 1951 19
Was permission obtained from the Conservation Division or its agents before plugging was commenced? Yes, orally

Name of Conservation Agent who supervised plugging of this well Mr. C. D. Stough, Great Bend, Ks.
Producing formation Arbuckle Depth to top 3748 Bottom 3755 Total Depth of Well 3773 Feet
Show depth and thickness of all water, oil and gas formations.

OIL, GAS OR WATER RECORDS

CASING RECORD

Formation	Content	From	To	Size	Put In	Pulled Out
Surface, Sand, Shale	--	0	390'	8 $\frac{1}{2}$ "	390'	0
Arbuckle	oil	3748	3755	5 $\frac{1}{2}$ "	3755	2650

Describe in detail the manner in which the well was plugged, indicating where the mud fluid was placed and the method or methods used in introducing it into the hole. If cement or other plugs were used, state the character of same and depth placed, from 250' feet to 30' feet for each plug set.

Plugged with Chat to 3730'. Dumped 5 sacks of cement. Worked casing loose at 2200' and mudded hole up to 250'. Set 10' rock bridge. Dumped 15 sacks cement muded up to 30'. Dumped 10 sacks cement on same.

MAR 29 1951
3-29-51
CONSERVATION DIVISION
Wichita, Kansas

(If additional description is necessary, use BACK of this sheet)


Correspondence regarding this well should be addressed to BEN F. BRACK OIL COMPANY, INC.
Address 309 Brown Building Wichita 2, Kansas

STATE OF Kansas, COUNTY OF Sedgwick, ss.
Emil E. Bowers (employee of owner) or (owner or operator) of the above-described well, being first duly sworn on oath, says: That I have knowledge of the facts, statements, and matters herein contained and the log of the above-described well as filed and that the same are true and correct. So help me God.

(Signature) Emil E. Bowers
Emil E. Bowers
309 Brown Building, Wichita 2, Ks.
(Address)

SUBSCRIBED AND SWORN to before me this 26 day of March, 19 51
Velda R. Evans
Notary Public.

My commission expires November 1, 1954

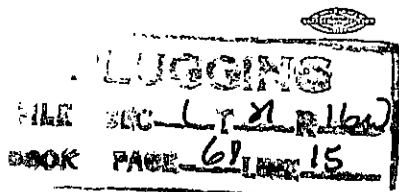

Ben F. Brack Oil Company, Inc.

Smith "B"

4

Sec. 1 T. 21 R. 16
Loc. SE NW SE

County: Pawnee

1-13-47³⁷⁷⁸

2-3-48

Ben F. Brack Oil Company, Inc.

Cellar	51	Line (Arbucklo)	3755
Pebbles and Sand	75	Line	3773
Shells, Gravel and Sand	160	Line	3778
Shale	200	Total Depth	3778
Shale	375		
Shale	390		
Sand	505		
Shale & Shells	550		
Sand and Gravel	610		
Shale & Red Bed	700		
Cement	700		
Red Bed and Shale	880		
Shale and Red Bed	960		
Lime	990		
Shale	1085		
Red sand and shale	1215		
Red Bed	1243		
Shale & Shells	1300		
Blue Shale	1360		
Shale & Salt	1484		
Salt and Shale	1610		
Shale & Lime	1770		
Lime & Shale	1835		
Lime	1950		
Lime	2045		
Lime	2105		
Lime	2160		
Lime	2230		
Lime	2285		
Lime	2335		
Lime	2440		
Lime & Shale	2530		
Lime & Shale	2610		
Lime & Shale	2680		
Lime & Shale	2770		
Lime & Shale	2865		
Lime & Shale	2945		
Lime & Shale	3010		
Lime & Shale	3085		
Lime	3150		
Lime	3190		
Lime	3230		
Lime	3280		
Lime	3330		
Lime	3390		
Lime, brown (K.C. Lansing)	3428		
Lime	3460		
Lime	3520		
Lime	3550		
Lime	3600		
Lime	3650		
Lime and Shale	3710		
Lime & Shale	3725		

RECEIVED
MAR 29 1951
CONSERVATION DIVISION
Wichita, Kansas

PLUGGING
FILE SEC-1 T-21 R-16
BOOK PAGE 68 LINE 15