


WELL PLUGGING RECORD

Give All Information Completely
Make Required Affidavit
Mail or Deliver Report to:
Conservation Division
State Corporation Commission
800 Bittling Building
Wichita, Kansas

Pawnee County, Sec. 1 Twp. 21S Rge. 16W (E) (W)

Location as "NE/CNW $\frac{1}{4}$ SW $\frac{1}{4}$ " or footage from lines CNE NW NE
Lease Owner Morris Sitrin
Lease Name Wise "B" Well No. 1
Office Address Box 1160, Tulsa, Oklahoma
Character of Well (completed as Oil, Gas or Dry Hole) Abandoned Oil Well
Date well completed June 30, 1947 19
Application for plugging filed November 8, 1951 19
Application for plugging approved November 8, 1951 19
Plugging commenced November 15, 1951 19
Plugging completed November 28, 1951 19
Reason for abandonment of well or producing formation oil depleted

NORTH

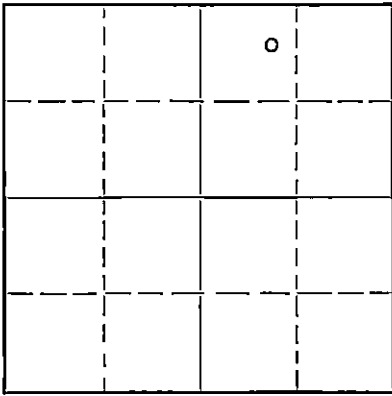

Locate well correctly on above Section Plat

If a producing well is abandoned, date of last production 19
Was permission obtained from the Conservation Division or its agents before plugging was commenced? Yes

Name of Conservation Agent who supervised plugging of this well C. D. Stough
Producing formation Arbuckle Depth to top 3767 Bottom 3817 Total Depth of Well 3817 Feet
Show depth and thickness of all water, oil and gas formations.

OIL, GAS OR WATER RECORDS

CASING RECORD

| Formation | Content | From | To | Size | Put In | Pulled Out |
|-----------|---------|------|----|--------|--------|------------|
| | | | | 8-5/8" | 1023 | |
| | | | | 5-1/2" | 3814 | 3420 |
| | | | | | | |
| | | | | | | |
| | | | | | | |
| | | | | | | |
| | | | | | | |
| | | | | | | |

Describe in detail the manner in which the well was plugged, indicating where the mud fluid was placed and the method or methods used in introducing it into the hole. If cement or other plugs were used, state the character of same and depth placed, from feet to feet for each plug set.

Set Lane wells plug at 3450 feet.
Plugged back with chat to 3420 feet
and dumped 5 sacks of cement at 3420 feet.
Shot off and pulled the 5 1/2" casing. Filled
with mud to 250 feet; set rock bridge and
20 sacks of cement at 250 feet. Filled with
mud to 35 feet set bridge and 10 sacks of cement
at the surface.

1-17-52

(If additional description is necessary, use BACK of this sheet)

Name of Plugging Contractor The West Supply Company
Address Chase, Kansas

STATE OF Kansas COUNTY OF Sedgewick, ss.
Morris Sitrin (employee of owner) or (owner or operator) of the above-described well,

being first duly sworn on oath, says: That I have knowledge of the facts, statements, and matters herein contained and the log of the above-described well as filed and that the same are true and correct. So help me God.

(Signature) Morris Sitrin
PO Box 1160, Tulsa, Okla (Address)

SUBSCRIBED AND SWORN to before me this 16th day of Jan 1952
Seward S. Greaves Notary Public.

My commission expires My Commission Expires Jan. 31, 1953

