


WELL PLUGGING RECORD

Give All Information Completely
Make Required Affidavit
Mail or Deliver Report to:
Conservation Division
State Corporation Commission
800 Bitting Building
Wichita, Kansas

NORTH

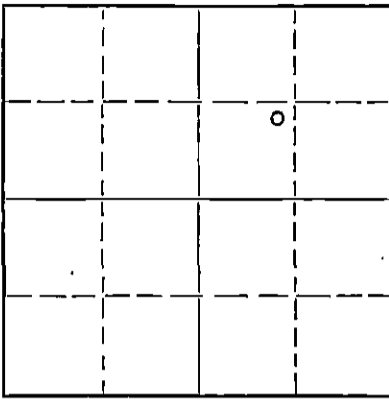

Locate well correctly on above
Section Plat

Pawnee County. Sec. 1 Twp. 21S Rge. 16W (W)
Location as "NE/CNW 1/4 SW 1/4" or footage from lines NE SW NE
Lease Owner Morris Sitrin
Lease Name Wise "B" Well No. 2
Office Address Box 1160, Tulsa, Oklahoma
Character of Well (completed as Oil, Gas or Dry Hole) abandoned oil well
Date well completed February 8, 1950 19
Application for plugging filed November 8, 1951 19
Application for plugging approved November 8, 1951 19
Plugging commenced November 10, 1951 19
Plugging completed November 24, 1951 19
Reason for abandonment of well or producing formation oil depleted

If a producing well is abandoned, date of last production 19
Was permission obtained from the Conservation Division or its agents before plugging was commenced? Yes

Name of Conservation Agent who supervised plugging of this well C. D. Stough
Producing formation Arbuckle Depth to top 3784 Bottom 3784 Total Depth of Well 3784 Feet
Show depth and thickness of all water, oil and gas formations.

OIL, GAS OR WATER RECORDS

CASING RECORD

Formation	Content	From	To	Size	Put In	Pulled Out
				8-5/8"	985	
				5-1/2	3786	

Describe in detail the manner in which the well was plugged, indicating where the mud fluid was placed and the method or methods used in introducing it into the hole. If cement or other plugs were used, state the character of same and depth placed, from feet to feet for each plug set.

Dumped 5 sacks of cement on bottom of hole. Shot off and pulled the 5-1/2 inch casing. Filled with mud to 250 feet. Set rock bridge and 20 sacks of cement at 250 feet. Filled with mud to 35 feet set bridge and 10 sacks of cement at the surface.

1-17-52

(If additional description is necessary, use BACK of this sheet)

Name of Plugging Contractor The West Supply Company
Address Chase, Kansas

STATE OF Oklahoma COUNTY OF Sedgewick, ss.
Morris Sitrin (employee of owner) or (owner or operator) of the above-described well,

being first duly sworn on oath, says: That I have knowledge of the facts, statements, and matters herein contained and the log of the above-described well as filed and that the same are true and correct. So help me God.

(Signature) Morris Sitrin
PO Box 1160 Tulsa, Okla.
(Address)

SUBSCRIBED AND SWORN to before me this 15th day of Jan 1952
Seward S. Greider
Notary Public.

My commission expires Jan. 31, 1953

23-8390, s. 8-51-20M
PLUGGING
FILE SEC 1 T 21 R 26W
BOOK PAGE 123 LINE 6