

STATE OF KANSAS
STATE CORPORATION COMMISSION

WELL PLUGGING RECORD

Give All Information Completely
Make Required Affidavit
Mail or Deliver Report to:
Conservation Division
State Corporation Commission
800 Bitting Building
Wichita, Kansas

FORMATION PLUGGING RECORD

Strike out upper line
when reporting plugging
of formations.

PAUNEE County. Sec. 1 Twp. 21 Rge. 16 (E) W. (W)

Location as "NE 1/4 NW 1/4 SW 1/4" or footage from lines SE SW SE

Lease Owner BEN F. BRACK OIL COMPANY, INC.

Lease Name Smith Well No. 2

Office Address 309-10 Brown Building

Character of Well (completed as Oil, Gas or Dry Hole)

Date well completed Dec. 2, 1947

Application for plugging filed NOV. 31, 1949

Application for plugging approved Oct. 31, 1949


Plugging commenced Oct. 31, 1949

Plugging completed Nov. 2, 1949

Reason for abandonment of well or producing formation D.H. & A

If a producing well is abandoned, date of last production June 6, 1948

Was permission obtained from the Conservation Division or its agents before plugging was commenced? Yes

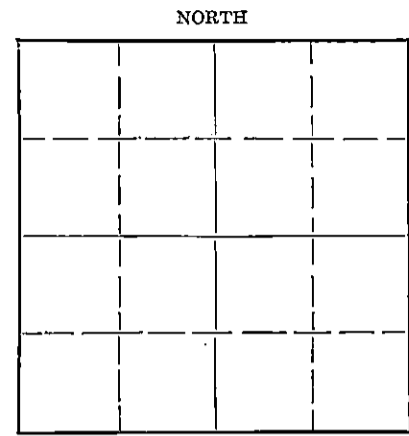

Locate well correctly on above Section Plat

Name of Conservation Agent who supervised plugging of this well C. D. Stough

Producing formation Arbuckle Depth to top 3750 Bottom Total Depth of Well 3773 Feet

Show depth and thickness of all water, oil and gas formations.

OIL, GAS OR WATER RECORDS

CASING RECORD

Formation	Content	From	To	Size	Put In	Pulled Out
Sand, Surface soil, clay		0	940'	8-5/8"	940'	
Arbuckle Lime		3750	3773	5 1/2"	3778'	2198'

Describe in detail the manner in which the well was plugged, indicating where the mud fluid was placed and the method or methods used in introducing it into the hole. If cement or other plugs were used, state the character of same and depth placed, from 250' feet to 30' feet for each plug set.

Plugged with Chat to 3730'. Dumped five (5) sacks of cement
Worked casing loose at 2200' and mudded hole up to 250'.
Set 10' rock bridge. Dumped fifteen (15) sacks cement
mudded up to 30'. Dumped ten (10) sacks of cement on same.

RECORDED
INDEXED
DEC 15 - 1949

11-6-49

(If additional description is necessary, use BACK of this sheet)

Correspondence regarding this well should be addressed to BEN F. BRACK OIL COMPANY, INC.
Address 309-10 BROWN BUILDING, WICHITA, KANSAS.

STATE OF KANSAS, COUNTY OF SEDGWICK, ss.
Henry B. Brack

(employee of owner) or (owner or operator) of the above-described well,
being first duly sworn on oath, says: That I have knowledge of the facts, statements, and matters herein contained and the log of the above-described well as filed and that the same are true and correct. So help me God.

(Signature) *Henry B. Brack*

BEN F. BRACK OIL COMPANY, INC. 310 Brown Bldg.
(Address)

SUBSCRIBED AND SWORN to before me this 29th day of November, 1949, Wichita, Ks.

Lucille A. Barenberg
Notary Public.

My commission expires October 5, 1953

PLUGGING
FILE SEC 1 T 21 R 16 W
BOOK PAGE 22 LINE 45

WELL LOG BUREAU - KANSAS GEOLOGICAL SOCIETY
412 Union National Bank Building, Wichita, Kansas

Company - Ben F. Brack Oil Co., Inc.

Sec. 1 T. 21 R. 16

Loc. SE SW SE

County Pawnee

Farm Smith No. 2

Total Depth: 3778'

Comm. 11-13-48 Comp. 11-29-48

Contractor - Ben F. Brack Oil Co., Inc.

Cellar	5
Sand, Gravel and Blue Shale	295
Shale and Shells	380
Sand	500
Shells and Red Bed	550
Shale and Sand Streaks	625
Shale	700
Shale Shells and Red Bed	880
Shells, Shale and Red Bed	952
Anhydrite	957
Lime	1000
Shale	1160
Red Bed, Shale and salt	1465
Shale and Shells	1715
Broken Lime	1715
Broken Lime	1935
Shale, Lime and Shells	1995
Lime	2060
Shale and Lime	2080
Shale	2090
Lime	2165
Lime	2260
Sandy Lime	2340
Lime and Shale	2430
Lime and Shale	2560
Shale and Shells	2720
Lime and Shale	2825
Lime and Shale	2895
Lime and Shale	3020
Lime and Shale	3155
Lime	3230
Lime	3275
Lime and Shale	3314
Lime	3390
Lime	3440
Lime	3465
Lime	3525
Lime	3560
Lime and Shale	3600
Lime	3643
Lime and chert	3700
Cong. & Shale	3738
Lime	3762
Total Depth	3778

INDEXED

DEC 6 - 1949

STATIONER ON
CORNER
KANSAS

WITNESS:

To the best of my knowledge the above is a true and correct record of the formations and depths at which found.

BY Lucille A. Barsberg

BEN F. BRACK OIL COMPANY, INC.

PLUGGING
NOV 21 1949
WICHITA, KANSAS

By

Henry G. Brack
Vice-President