


STATE OF KANSAS
STATE CORPORATION COMMISSION
200 Colorado Derby Bldg.
Wichita, Kansas 67202

Form CP-4
Rev. 12-15-80

WELL PLUGGING RECORD

Give All Information Completely
Make Required Affidavit

COUNTY Pawnee SEC. 1 TWP. 21 RGE. 16 E/W
Location as in quarters or footage from lines:
330 ft. from East line & 330 ft. from South line. (SW4)

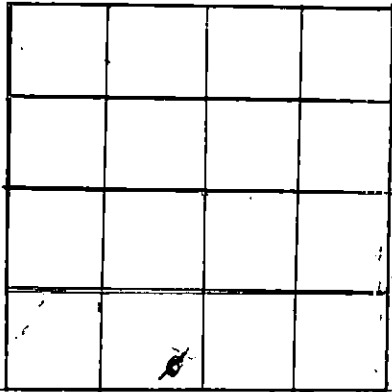

Locate Well
correctly on above
Section Platt.

Lease Owner Hupfer Oil & Gas
Lease Name Barrett Well No. #2
Office Address 3711 Country Lane, Hays, Kansas 67610
Character of Well (Completed as Oil, Gas or Dry Hole): Dry Hole
Date Well Completed 8-22-83
Application for plugging filed Attached (Verbal approval from
Plugging commenced 8-22-83, 1:00 p.m. Mr. Steve Durant)
Plugging completed 8-22-83, 1:50 p.m.
Reason for abandonment of well or producing formation Fish IN
hole-could not mill over.
Was permission obtained from the Conservation Division or it's
Agent's before plugging was commenced? Yes

Name of Conservation Agent who supervised plugging of this well Mr. Benny Beck
Producing formation Arbuckle Depth to top 3754 bottom 3860 T.D. 3860
Show depth and thickness of all water, oil and gas formations.

OIL, GAS OR WATER RECORDS

Casing Record

Formation	Content	From	To	Size	Put in	Pulled Out
Shale/Sand	Surface pipe	0	955	8-5/8	955	none
Lime/Shale	Prod. pipe	0	3858	5 1/2	3858	1950 ft.

Describe in detail the manner in which the well was plugged, indicating where the mud fluid was placed and the method or methods used in introducing it into the hold. If cement or other plugs were used, state the character of same and depth placed, from _____ feet to _____ feet for each plug set.

- 1) Fish - 2-7/8" tubing. Squeezed and cemented in hole from 3770 to 3260.
- 2) Dumped 5 sxs. sand and 5 sxs. cement on top of fish @ 3260 with bailer.
- 3) Mixed 3 sxs. hulls, 10 sxs. gel, 50 sxs. cement, 60/40 Poz, 2% gel, 3% cc. Release plug and mix 125 sxs. cement 60/40 Poz, 2% gel, 3% cc. Minimum 500 PSI - shut in - maximum 900 PSI

RECEIVED
STATE CORPORATION COMMISSION
SEP 19 1983
9-19-83
CONSERVATION DIVISION
Wichita, Kansas

(If additional description is necessary, use BACK of this sheet)
Name of Plugging Contractor Sun OilWell Cementing Co.

STATE OF Kansas COUNTY OF Ellis, ss.
Dennis D. Hupfer (~~employee or operator~~) or (owner or operator) of the above-described well, being first duly sworn on oath, says: That I have knowledge of the facts, statements, and matters herein contained and the log of the above-described well as filed and that the same are true and correct. So help me God.
(Signature) [Signature]
3711 Country Lane, Hays, Ks.
(Address) 67601

SUBSCRIBED AND SWORN TO before me this 16 day of September, 19 83

My Commission expires: 2-1-85

[Signature]
EMERY J. ROME
NOTARY PUBLIC
STATE OF KANSAS
My Appointment Expires:
2-1-85
Notary Public.