

STATE OF KANSAS
STATE CORPORATION COMMISSION

Give All Information Completely
Make Required Affidavit
Mail or Deliver Report to:
Conservation Division
State Corporation Commission
211 No. Broadway
Wichita, Kansas

WELL PLUGGING RECORD

Hodgeman County. Sec. 3 Twp. 21S Rge. 22W (E) (W)

Location as "NE/CNWSW" or footage from lines. C-SE-SE

Lease Owner Surray DX Oil Company

Lease Name Gerald Moore Well No. 1

Office Address 321 West Douglas, Wichita 2, Kansas

Character of Well (completed as Oil, Gas or Dry Hole) Dry Hole

Date well completed 19

Application for plugging filed July 16, 19 62

Application for plugging approved July 13, 19 62


Plugging commenced July 13, 19 62

Plugging completed July 14, 19 62

Reason for abandonment of well or producing formation Non-Commerical

If a producing well is abandoned, date of last production 19

Was permission obtained from the Conservation Division or its agents before plugging was commenced? Yes

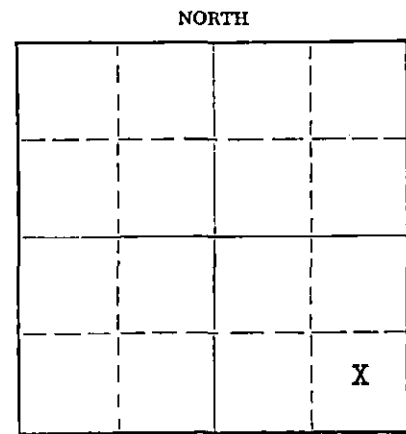

Name of Conservation Agent who supervised plugging of this well Hugh Scott

Producing formation Depth to top Bottom Total Depth of Well 4363 Feet

Show depth and thickness of all water, oil and gas formations.

OIL, GAS OR WATER RECORDS

CASING RECORD

FORMATION	CONTENT	FROM	TO	SIZE	PUT IN	PULLED OUT
Osage	Water	4273	4350	8 5/8"	263'	-0-
Kinderhook	Water	4350	4363			

Describe in detail the manner in which the well was plugged, indicating where the mud fluid was placed and the method or methods used in introducing it into the hole. If cement or other plugs were used, state the character of same and depth placed, from feet to feet for each plug set.

Filled hole with mud from total depth to 260' and dump 30 sacks of cement. Fill hole with mud to 40' and dump 15 sacks of ~~ROMEX~~ cement. Fill hole with mud and dump 5 sacks of cement to cap well.

RECEIVED
STATE CORPORATION COMMISSION

JUL 2 1962

CONSERVATION DIVISION
Wichita, Kansas

7-24-62

(If additional description is necessary, use BACK of this sheet)

Name of Plugging Contractor Stickle Drilling Company

Address 1100 Bitting Building, Wichita, Kansas

STATE OF Kansas, COUNTY OF Sedgwick, ss.

Gary W. Pierce (employee of owner) or (owner or operator) of the above-described well, being first duly sworn on oath, says: That I have knowledge of the facts, statements, and matters herein contained and the log of the above-described well as filed and that the same are true and correct. So help me God.

(Signature) Gary W. Pierce

321 West Douglas, Wichita 2, Kansas (Address)

SUBSCRIBED AND SWORN TO before me this 23rd day of July, 19 62

My commission expires July 13, 1963

Notary Public.


WELL LOG BUREAU—KANSAS GEOLOGICAL SOCIETY
508 East Murdock, Wichita, Kansas

Company- SUNRAY DK OIL CO.
Farm- Gerald Moore No. 1

SEC. 3 T. 21 R. 22W
C SE SE

Total Depth. 4363'
Comm. 7-2-62 Comp. 7-14-62
Shot or Treated.
Contractor. Stickle Drilling Co.
Issued. 10-27-62

County Hodgeman
KANSAS

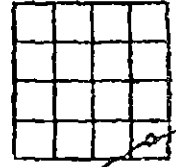

CASING:
8" 263' cem w/200 sx.

Elevation. 2176' DE

Production. Dry

Figures Indicate Bottom of Formations.

clay	50
sand	85
shale	265
sandy shale	395
shale & red bed	710
red bed	740
sand	955
anhydrite	1371
shale & shells	1780
lime & shale	1840
shale, red bed & lime	2155
shale & lime	2320
lime & shale	2455
shale & lime	2555
lime	2677
shale & lime streaks	2780
shale & lime	2914
shale	3190
shale w/streaks of chalky lime	3324
shale & chalk	3478
shale & sand	3635
shale & lime	3756
lime	4270
lime & chert	4342
lime & cherty lime	4363
Total Depth	

TOPS: LOG	
Heebner	3624
Toronto	3646
Douglas Shale	3657
Lansing	3675
Base Kansas City	3962
Marmaton	4031
Ft. Scott	4108
Cherokee	4172
Mississippi Warsaw	4244
Mississippi Osage	4272
Kinderhook Lime	4342