


STATE OF KANSAS
STATE CORPORATION COMMISSION

WELL PLUGGING RECORD

Give All Information Completely
Make Required Affidavit
Mail or Deliver Report to
Conservation Division
State Corporation Comm.
245 North Water
Wichita, KS 67202

Hodgeman County, Sec. 2 Twp. 21S Rge. 22W 1/4W
Location as "NE/CNW 1/4 SW 1/4" or footage from lines
C NE/4 SW/4

Lease Owner John O. Farmer, Inc.
Lease Name Chaffee Well No. 1
Office Address Box 352, Russell, Kansas 67665
Character of Well (Completed as Oil, Gas or Dry Hole) _____

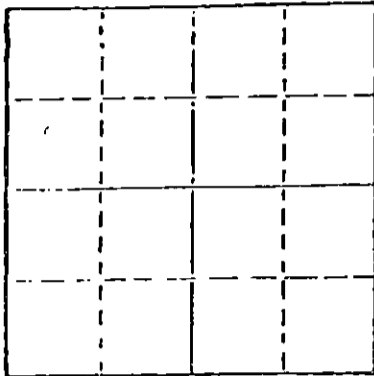

Locate well correctly on above
Section Plat

D & A
Date Well completed August 5, 1978
Application for plugging filed August 5, 1978
Application for plugging approved August 5, 1978
Plugging commenced August 5, 1978
Plugging completed August 5, 1978
Reason for abandonment of well or producing formation _____

D & A
If a producing well is abandoned, date of last production 19__

Was permission obtained from the Conservation Division or its agents before plugging was commenced? Yes

Name of Conservation Agent who supervised plugging of this well Clarence Thomas, Jr.
Producing formation _____ Depth to top _____ Bottom _____ Total Depth of Well 4,370'
Show depth and thickness of all water, oil and gas formations.

OIL, GAS OR WATER RECORDS

CASING RECORD

| FORMATION | CONTENT | FROM | TO | SIZE | PUT IN | PULLED OUT |
|-----------|---------|------|----|--------|---------|------------|
| | | | | 8 5/8" | 289.60' | -0- |
| | | | | | | |
| | | | | | | |
| | | | | | | |

Describe in detail the manner in which the well was plugged, indicating where the mud fluid was placed and the method or methods used in introducing it into the hold. If cement or other plugs were used, state the character of same and depth placed, from _____ feet to _____ feet for each plug set.

RECEIVED
STATE CORPORATION COMMISSION
AUG 10 1978
CONSERVATION DIVISION
Wichita, Kansas

Bottom plug @ 4,300' w/40 sx cement
2nd Plug @ 1,000' w/35 sx cement
Top plug @ 300' w/35 sx cement
Cement was 50/50 Pozmix, 2% Gel

8-10-78

(If additional description is necessary, use BACK of this sheet)

Name of Plugging Contractor Red Tiger Drilling Company
1720 KSB&T Building, Wichita, Kansas 67202


STATE OF Kansas COUNTY OF Sedgwick, ss. contractor
Gloria Fawcett (employee of ~~XXXXXXXXXXXXXXXXXXXXXXXXXXXXXXXXXXXX~~)

of the above-described well, being first duly sworn on oath, says: That I have knowledge of the facts, statements, and matters herein contained and the log of the above-described well as filed and that the same are true and correct. So help me God.

(Signature) Gloria Fawcett
1720 KSB&T Building, Wichita, Kansas 67202
(Address)

SUBSCRIBED AND SWORN TO before me this 8th day of August, 1978.

My commission expires _____
Joyce A. Hagermann
Notary Public.

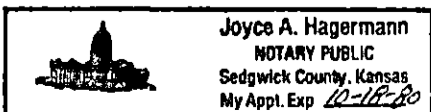

DRILLERS LOG

No. 1 Chaffee

| | | |
|----------------------------------|--|--|
| CASING RECORD: | COMPANY: John O. Farmer, Inc. | DESCRIPTION: |
| 8 5/8" @ 296' w/175 sx cement | CONTRACTOR: Red Tiger Drilling Company | C NE/4 SW/4 Sec. 2-T21S-R22W Hodgeman County, Kansas |
| | COMMENCED: July 28, 1978 | |
| | COMPLETED: August 5, 1978 | |
| TOTAL DEPTH: 4,370' | | ELEVATION: 2,165' KB |

| <u>FORMATION</u> | <u>FROM</u> | <u>TO</u> | <u>REMARKS</u> |
|---------------------|-------------|-----------|----------------|
| Surface Clay & Sand | 0 | 105 | |
| Red Bed & Shale | 105 | 297 | |
| Shale | 297 | 785 | |
| Sand | 785 | 985 | |
| Shale | 985 | 1327 | |
| Anhydrite | 1327 | 1361 | |
| Shale | 1361 | 1630 | |
| Shale & Shells | 1630 | 1940 | |
| Shale | 1940 | 2160 | |
| Shale & Lime | 2160 | 2345 | |
| Lime & Shale | 2345 | 3685 | |
| Lime | 3685 | 4370 | |
| RTD | | 4370 | |

I certify that this is a true and correct copy of the above log to the best of my knowledge.

RED TIGER DRILLING COMPANY

Gloria Fawcett
Gloria Fawcett

Subscribed and sworn to before me this 8th day of August, 1978.

RECEIVED
STATE CORPORATION COMMISSION
AUG 10 1978
CONSERVATION DIVISION
Wichita, Kansas

Joyce A. Hagermann
Notary Public

