


WELL PLUGGING RECORD

Give All Information Completely
Make Required Affidavit
Mail or Deliver Report to:
Conservation Division
State Corporation Commission
800 Bitting Building
Wichita, Kansas

NORTH

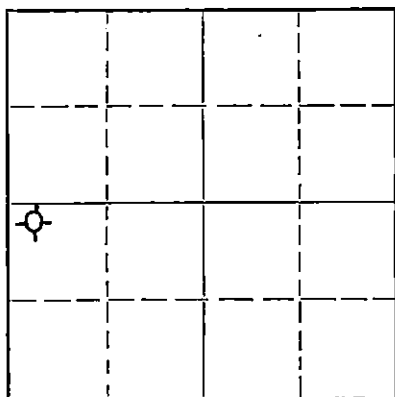

Locate well correctly on above
Section Plat

Pawnee County, Sec. 13 Twp 21S Rge. (E) 15 (W)
Location as "NE/CNW/SW" or footage from lines. NW NW SW
Lease Owner C. U. Bay
Lease Name Dupree Well No. 1
Office Address 1006 Brown Building, Wichita, Kansas
Character of Well (completed as Oil, Gas or Dry Hole) Dry Hole
Date well completed October 11, 19 53
Application for plugging filed October 12, (Written) 19 53
Application for plugging approved October 12, 19 53
Plugging commenced October 11, 19 53
Plugging completed October 11, 19 53
Reason for abandonment of well or producing formation ---

If a producing well is abandoned, date of last production --- 19
Was permission obtained from the Conservation Division or its agents before plugging was commenced? Yes

Name of Conservation Agent who supervised plugging of this well M. A. Rives, Box 148, Pratt, Kansas
Producing formation _____ Depth to top _____ Bottom _____ Total Depth of Well 3812 Feet
Show depth and thickness of all water, oil and gas formations.

OIL, GAS OR WATER RECORDS

CASING RECORD

FORMATION	CONTENT	FROM	TO	SIZE	PUT IN	PULLED OUT
				8-5/8	905'	None

Describe in detail the manner in which the well was plugged, indicating where the mud fluid was placed and the method or methods used in introducing it into the hole. If cement or other plugs were used, state the character of same and depth placed, from _____ feet to _____ feet for each plug set.

Filled hole with mud to 300'. Set plug and cemented with 20 sacks. Filled hole with mud to 40'. Set plug and cemented with 10 sacks.

RECORDED
STATE CORPORATION COMMISSION

OCT 20 1953 10-20-53

CONSERVATION DIVISION
Wichita, Kansas

(If additional description is necessary, use BACK of this sheet)
Name of Plugging Contractor Rocket Drilling Company
Address 352 North Broadway, Wichita 2, Kansas

STATE OF Kansas COUNTY OF ~~Sedgewick~~ Rice ss.
Alex. E. Amos (owner or operator) of the above-described well, being first duly sworn on oath, says: That I have knowledge of the facts, statements, and matters herein contained and the log of the above-described well as filed and that the same are true and correct. So help me God.
(Signature) Alex. E. Amos

SUBSCRIBED AND SWORN TO before me this 19 day of October, 19 53

My commission expires May 20, 1954
Clement C. Gray Notary Public.

24-7368-5 3-53-20M

PLUGGING
FILE SEC 13 T 21 R 15W
BOOK PAGE 135 LINE 11

ROCKET DRILLING COMPANY
 352 North Broadway
Wichita 2, Kansas

C. U. Bay
 1006 Brown Building
 Wichita, Kansas

#1 Dupree
 NW NW SW, 13-21-15W
 Pawnee County, Kansas

Elevation: 1949 R.B.
 Spudded: September 28, 1953
 Rotary Completed: October 10, 1953
 Initial Production: Dry & Abandoned
 Contractor: Rocket Drilling Company

CASING RECORD

905' 8-5/8" O. D. 24# Seamless Casing Cemented W/450 Sacks Cement.
 5-1/2" None.

DRILLERS LOG

Sand	0 to 160	Sand	2040 to 2055
Blue Shale	340	Lime & Shale	2090
Sand	430	Shale & Lime	2235
Red Shale	510	Lime & Shale	2516
Sand	550	Shale & Lime	2600
Red Shale	595	Shale & Shells	2715
Red Bed	780	Lime & Shale	2850
Red Shale	900	Shale & Lime	2972
Anhydrite	934	Lime	3333
Shale & Shells	1625	Shale & Lime	3436
Salt	1770	Lime	3670
Lime & Shale	1810	Conglomerate Chert	3725
Lime	1905	Chert & Shale	3749
Sand	1940	Simpson	3800
Lime	2040	Arbuck	3812 TD

STATE OF KANSAS) SS:
 SEDGWICK COUNTY)

I hereby certify that to the best of my knowledge and belief, the foregoing log is true and correct.

ROCKET DRILLING COMPANY
 By: [Signature]

Subscribed and sworn to before me, a Notary Public, in and for the State and County aforesaid this 13th day of October, 1953.

[Signature]
 Notary Public

My Commission Expires: 12-3-55
PLUGGING
 FILE SEC 13 T 21 R 15W
 BOOK PAGE 135 LINE 11

RECEIVED
 STATE COMMISSION
 OCT 20 1953
 CONSERVATION DIVISION