

STATE OF KANSAS
STATE CORPORATION COMMISSION


WELL PLUGGING RECORD

Give All Information Completely
Make Required Affidavit
Mail or Deliver Report to:
Conservation Division
State Corporation Commission
211 No. Broadway
Wichita, Kansas

Pawnee County. Sec. 13 Twp. 21 Rge. 15 (E) W (W)

Location as "NE/CNW/SW" or footage from lines NE NE SE
Lease Owner Robinowitz Oil Company
Lease Name Showalter Well No. 1
Office Address 311 Shell Building Tulsa, Oklahoma
Character of Well (completed as Oil, Gas or Dry Hole) dry hole
Date well completed January 30 19 59
Application for plugging filed January 30 19 59
Application for plugging approved January 30 19 59
Plugging commenced January 30 19 59
Plugging completed 7:00 a.m. January 30 19 59
Reason for abandonment of well or producing formation dry hole

NORTH

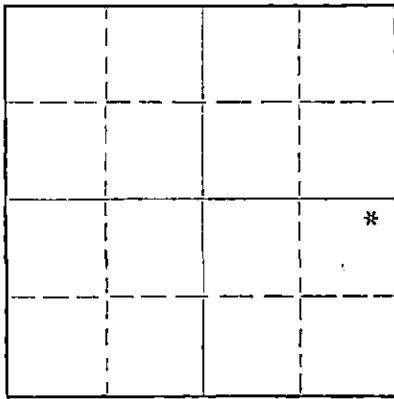

Locate well correctly on above
Section Plat

If a producing well is abandoned, date of last production _____ 19 ____
Was permission obtained from the Conservation Division or its agents before plugging was com-
menced? Yes

Name of Conservation Agent who supervised plugging of this well Frank Broadfoot
Producing formation _____ Depth to top _____ Bottom _____ Total Depth of Well 3890' Feet
Show depth and thickness of all water, oil and gas formations.

OIL, GAS OR WATER RECORDS

CASING RECORD

FORMATION	CONTENT	FRDM	TD	SIZE	PUT IN	PULLED OUT
Surface Pipe		-0-	270'	8 5/8"	270'	-0-

Describe in detail the manner in which the well was plugged, indicating where the mud fluid was placed and the method or methods used in introducing it into the hole. If cement or other plugs were used, state the character of same and depth placed, from _____ feet to _____ feet for each plug set.

Plugged hole with 85 sacks cement through
surface pipe - by Halliburton Oil Well
Cementing Company

2-10-59

RECEIVED
STATE CORPORATION COMMISSION

FEB 10 1959

CONSERVATION DIVISION
Wichita, Kansas

(If additional description is necessary, use BACK of this sheet)
Name of Plugging Contractor Halliburton Oil Well Cementing,
Address Duncan, Oklahoma

STATE OF Kansas, COUNTY OF Barton, ss.
C. L. Miles, partner of contractor (employee of owner) (owner or operator) of the above-described well, being first duly sworn on oath, says: That I have knowledge of the facts, statements, and matters herein contained and the log of the above-described well as filed and that the same are true and correct. So help me God.

(Signature) C. L. Miles

(Address)

SUBSCRIBED AND SWORN to before me this 5th day of February, 19 59

Notary Public

My commission expires May 9, 1959

PLUGGING
FILE SEC 13 T. 21 R. 15W
BOOK PAGE 19 LINE 22

W E L L L O G
 Showalter # 1
 NE NE SE 13-21-15
 Barton County, Kansas

0 - 35	Surface soil	Elevation	1940' D.F.
35 - 185	Sand		
185 - 350	Blue shale		
350 - 445	Sand	<u>Formation Tops:</u>	
445 - 910	Red bed and shale	Anhydrite	910'
910 - 945	Anhydrite	Heebner	3339'
945 - 965	Shale and shells	Brown lime	3435'
965 - 1235	Shale	Lansing	3444'
1235 - 1365	Shale and shells	Conglomerate chert	3738'
1365 - 1665	Shale, shells and salt	Viola chert	3754'
1665 - 1752	Shale	Simpson	3832'
1752 - 1850	Shale and lime	Arbuckle	3873'
1850 - 1955	Lime and shale		
1955 - 2085	Lime - Ft. Riley		
2085 - 2165	Lime		
2165 - 2220	Shale		
2220 - 2365	Shale with streaks lime		
2365 - 2440	Shale and lime		
2440 - 2600	Shale and shells		
2600 - 2970	Shale and lime		
2970 - 3085	Shale with lime streaks		
3085 - 3115	Lime with shale breaks		
3115 - 3175	Lime		
3175 - 3200	Shale		
3200 - 3285	Lime - broken		
3285 - 3350	Lime		
3350 - 3505	Shale and lime		
3505 - 3710	Lime		
3710 - 3813	Lime and chert		
3813 - 3827	Chert		
3827 - 3880	Cherty lime		
3880 - 3890	Lime		
3890	T. D.		

STATE OF KANSAS
 Notary Public
 C. L. Miles

Set 270' of 8 5/8" surface pipe with 250 sacks cement.

STATE OF KANSAS

COUNTY OF BARTON ss

C. L. Miles, partner of A. L. Jackson Drilling Company, being first duly sworn on oath says: That I have knowledge of the facts, statements and matters herein contained and the log of the above described well as filed and that the same are true and correct.

C. L. Miles
 C. L. Miles

Subscribed and sworn before me this 4th day of February, 1959.

Notary Public
 Notary Public Barton County

My Commission expires: 5-9-59

PLUGGING
 FILE SEC. 13 T 21 R 15W
 BOOK PAGE 19 LINE 22