

STATE OF KANSAS STATE CORPORATION COMMISSION

WELL PLUGGING RECORD

JAN 16 1978

1-16-78

Give All Information Completely Make Required Affidavit Mail or Deliver Report to Conservation Division State Corporation Comm. 245 North Water Wichita, KS 67202

Pawnee County, Sec. 12, Twp 21 N, Rge. 15 E/W Location as "NE/CNW 1 SW 1" or footage from lines SW NE NE


Lease Owner F & M Oil Company Lease Name Converse Well No. 1 Office Address 505 Union Center Wichita, Kansas 67202 Character of Well (Completed as Oil, Gas or Dry Hole) Dry Hole

Date Well completed 1-6-1978 Application for plugging filed 1-6-1978 Application for plugging approved 1-6-1978 Plugging commenced 1-6-1978 Plugging completed 5:30 P. M. 1-6-1978 Reason for abandonment of well or producing formation

If a producing well is abandoned, date of last production 19

Was permission obtained from the Conservation Division or its agents before plugging was commenced? yes

Name of Conservation Agent who supervised plugging of this well Leo Massey Producing formation Depth to top Bottom Total Depth of Well 3800' Show depth and thickness of all water, oil and gas formations.

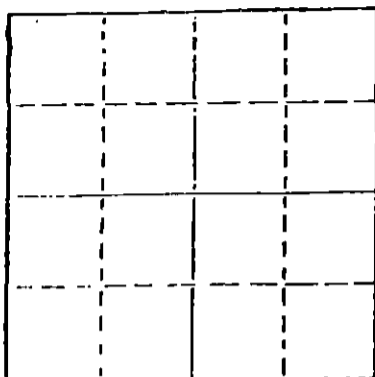

Locate well correctly on above Section Plot

OIL, GAS OR WATER RECORDS

CASING RECORD

Table with 7 columns: FORMATION, CONTENT, FROM, TO, SIZE, PUT IN, PULLED OUT

Describe in detail the manner in which the well was plugged, indicating where the mud fluid was placed and the method or methods used in introducing it into the hold. If cement or other plugs were used, state the character of same and depth placed, from feet to feet for each plug set.

Pumped 40 SX common cement thru O.E. Drill Pipe @ 420' Mud to 40' 1/2 sack hulls, wood plug for solid bridge, Pumped 10 sx to surface. 2 sx in rat hole (common) by Allied

(If additional description is necessary, use BACK of this sheet)

Name of Plugging Contractor

STATE OF Kansas COUNTY OF Barton ss. Gary Bagby (employee of owner) or (owner/operator)

of the above-described well, being first duly sworn on oath, says: That I have knowledge of the facts, statements, and matters herein contained and the log of the above-described well as filed and that the same are true and correct. So help me God.

(Signature) Gary Bagby Sterling Kansas (Address)

SUBSCRIBED AND SWORN TO before me this 9th day of January, 19 78

Bessie M. DeWerff Notary Public.

My commission expires 5-20-81

BESSIE M. DEWERFF STATE NOTARY PUBLIC BARTON COUNTY, KANSAS MY APPT. EXP. 5-20-81

DRILLERS WELL LOG

L. D. DRILLING COMPANY - CONTRACTOR

F & M OIL COMPANY, INC. - OPERATOR

CONVERSE # 1
SW NE NE 13-21-15
PAWNEE COUNTY, KANSAS

T. D. 3800'
ELEV. 1940 KB

COMMENCED: 12-22-77
COMPLETED: 1-6-78

CASING

CEMENT

8-5/8" set at 918'

W/225 sx 60/40 Pozmix, 2% Gel, 3% CC
200 sx Common, 2% Gel, 3% cc

FORMATION

DEPTH

Shale & Sand
Sand
Shale & Red Bed
Anhy.
Shale, shells & salt
Lime & Shale
Shale & Lime
Lime & Shale

0 - 355
355 - 450
450 - 906
906 - 937
937 - 1848
1848 - 3291
3291 - 3393
3393 - 3800

TOPS

Dakota Sand
Anhy.
Herrington
Winfield
Towanda
Ft. Riley
Council Grove
Neva
Foraker
Waubunsee
Tarkio
Elmont
Howard
Topeka
Heebner
Toronto
Douglas Shale
Brn. Lime
Lansing
Base K/C
Conglomerate
Viola
Simpson
Arbuckle
RTD

355
906
1848
1919
1976
2020
2185
2357
2418
2601
2730
2793
2862
2933
3291
3307
3324
3393
3404
3626
3650
3666
3717
3790
3800

RECEIVED
STATE CORPORATION COMMISSION

JAN 16 1978

CONSERVATION DIVISION
Wichita, Kansas

AFFIDAVIT

State of Kansas County of Barton

I, Gary Bagby of the L. D. Drilling Company

being first duly sworn on oath, State: That I have knowledge of the facts statements and matters herein contained and that the same are true and correct.

Gary Bagby
Gary Bagby

Subscribed and sworn to before me on this 11th day of January 1978

My commission expires: 5-20-81

Bessie M. DeWerff
Notary Public: Bessie M. DeWerff

BESSIE M. DEWERFF
STATE NOTARY PUBLIC
BARTON COUNTY, KANSAS
MY APPT. EXP. 5-20-81