

WELL PLUGGING RECORD

Give All Information Completely  
Make Required Affidavit  
Mail or Deliver Report to:  
Conservation Division  
State Corporation Commission  
211 No. Broadway  
Wichita, Kansas

Pawnee County. Sec. 12' Twp. 21S Rge. 15 (EX) (W)

Location as "NE/CNW/SW" or footage from lines SE NE SW

Lease Owner D. R. Lauck Oil Company, Inc.

Lease Name Darcey Well No. 1

Office Address 301 South Broadway Wichita 2 Kans

Character of Well (completed as Oil, Gas or Dry Hole) dry hole

Date well completed April 22 19 58

Application for plugging filed April 22 19 58

Application for plugging approved April 22 19 58


Plugging commenced April 22 19 58

Plugging completed April 22 19 58

Reason for abandonment of well or producing formation dry hole

If a producing well is abandoned, date of last production 19

Was permission obtained from the Conservation Division or its agents before plugging was commenced? yes

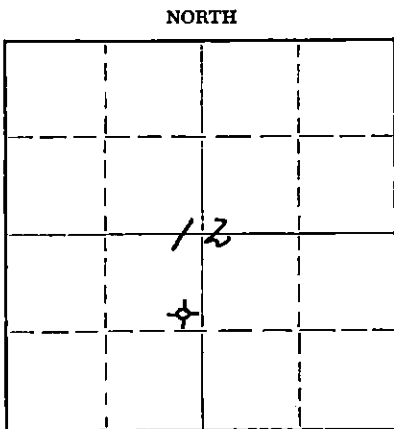

Locate well correctly on above Section Plat

Name of Conservation Agent who supervised plugging of this well Frank Broadfoot

Producing formation \_\_\_\_\_ Depth to top \_\_\_\_\_ Bottom \_\_\_\_\_ Total Depth of Well 3920 Feet

Show depth and thickness of all water, oil and gas formations.

OIL, GAS OR WATER RECORDS

CASING RECORD

FORMATION	CONTENT	FROM	TO	SIZE	PUT IN	PULLED OUT
		0	662	8 5/8"	662	none

Describe in detail the manner in which the well was plugged, indicating where the mud fluid was placed and the method or methods used in introducing it into the hole. If cement or other plugs were used, state the character of same and depth placed, from \_\_\_\_\_ feet to \_\_\_\_\_ feet for each plug set.

hole filled with mud 3920 - 300  
 plug 300 - 296  
 cement 296 - 35  
 plug 35 - 31  
 cement 31 - 6 bottom of cellar

4-29-58

STATE CORPORATION COMMISSION  
 APR 29 1958  
 CONSERVATION DIVISION  
 Wichita, Kansas

(If additional description is necessary, use BACK of this sheet)  
 Name of Plugging Contractor Globe Cementing Company  
 Address Great Bend Kansas

STATE OF Kansas, COUNTY OF Sedgwick, ss.  
John H. Knightley (employee of owner) of (owner of property) of the above-described well, being first duly sworn on oath, says: That I have knowledge of the facts, statements, and matters herein contained and the log of the above-described well as filed and that the same are true and correct. So help me God.

(Signature) John H. Knightley  
Wichita Kansas  
 (Address)

SUBSCRIBED AND SWORN TO before me this 25 day of April, 19 58

My commission expires Sept. 14, 1959  
Elizabeth Kay Notary Public.

PLUGGING  
 FILE SEC 12 T 21 R 15-60  
 BOOK PAGE 76 LINE 17

D. R. Lauck Oil Company, Inc.

Darcey #1

SE NE SW Sec.12-21S-15W  
Pawnee County, KansasCommenced: April 12, 1958  
Completed: April 22, 1958

Casing Record: 662 ft 8 5/8" cem.with 425 sx

Elevation: GR 1948; DF 1951; KB 1953

Drillers LogTops

sand	170	Anhydrite	930+1023
shale	360	Heebner	3320-1367
sand	465	Brown Lime	3424-1471
red bed, shale & sand	662	Lansing Kansas City	3435-1482
red bed & shale	930	Base Kansas City	3675-1722
Anhydrite	948	Conglomerate	3721-1768
shale & shells	1660	Viola	3745-1792
lime & shale	1990	Simpson shale	3803-1850
shale & lime	2700	Rotary Total Depth	3920-1967
lime & shale	3020		
Lime	3310		
Lime & shale	3395	D & A	
Douglas	3425		
Lime	3770		
Viola chert	3830		
lime chert & shale	3900		
lime & shale	3920	RTD	

