


STATE OF KANSAS
STATE CORPORATION COMMISSION

WELL PLUGGING RECORD

Give All Information Completely.
Make Required Affidavit
Mail or Deliver Report to
Conservation Division
State Corporation Comm.
245 North Water
Wichita, KS 67202

Pawnee County. Sec. 2 Twp. 21 Rge. 16 NE/W
Location as "NE/CNW $\frac{1}{4}$ SW $\frac{1}{4}$ " or footage from lines _____
SE NE SE
Lease Owner Brougher Oil, Inc.
Lease Name Barrett "A" Well No. 2
Office Address Drawer 1367, Great Bend, Kansas 67530
Character of Well (Completed as Oil, Gas or Dry Hole) _____

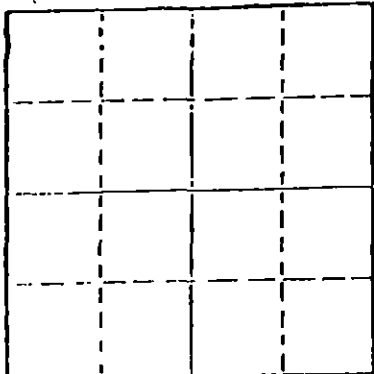

Locate well correctly on above
Section Plat

Date Well completed Oct. 29 1980
Application for plugging filed Oct. 29 1980
Application for plugging approved Oct. 29 1980
Plugging commenced Oct. 29 1980
Plugging completed Oct. 29 1980
Reason for abandonment of well or producing formation _____
dry

If a producing well is abandoned, date of last production _____
19 _____

Was permission obtained from the Conservation Division or
its agents before plugging was commenced? yes

Name of Conservation Agent who supervised plugging of this well Leo Massey
Producing formation _____ Depth to top _____ Bottom _____ Total Depth of Well 3805
Show depth and thickness of all water, oil and gas formations.

OIL, GAS OR WATER RECORDS

CASING RECORD

FORMATION	CONTENT	FROM	TO	SIZE	PUT IN	PULLED OUT
				8 5/8	1006	

Describe in detail the manner in which the well was plugged, indicating where the mud fluid was placed and the method or methods used in introducing it into the hold. If cement or other plugs were used, state the character of same and depth placed, from _____ feet to _____ feet for each plug set.

1st plug 930 w/60 sx.
2nd plug 270 w/30 sx.
3rd plug 40 w/10 sx.

5 sx in rathole

RECEIVED
STATE CORPORATION COMMISSION

NOV - 4 1980

(If additional description is necessary, use BACK of this sheet)

Name of Plugging Contractor Woodman & Iannitti Drilling Co.
Conservation Division
Wichita, Kansas

STATE OF KANSAS COUNTY OF SEDGWICK, ss.
K. T. Woodman (employee of owner) or (owner or operator)
of the above-described well, being first duly sworn on oath, says: That I have knowledge of the facts, statements, and matters herein contained and the log of the above-described well as filed and that the same are true and correct. So help me God.

(Signature) K. T. Woodman

1008 Douglas Bldg. 104 So. Broadway
(Address)

SUBSCRIBED AND SWORN TO before me this 31st day of October, 19 80

Justina Chamberlain
Justina Chamberlain Notary Public.

My commission expires Feb. 11, 1984

K. T. WOODMAN
 RES. PHONE 733-0418
 OFF. PHONE 265-7650
 WICHITA, KANSAS

D. J. IANNITTI
 PHONE 792-2921
 GREAT BEND, KANSAS

WOODMAN & IANNITTI DRILLING COMPANY

Rotary Drilling Contractors

1008 DOUGLAS BUILDING
 104 S. BROADWAY
 WICHITA, KANSAS 67202

October 31, 1980

Company;	Brougner Oil Inc.
Farm;	#2 Barrett "A"
Location;	SE NE SE
Section;	2-21S-16W
County;	Pawnee
Contractor;	Woodman & Iannitti Drilling Co.
Comm;	October 23, 1980
Compl;	October 29, 1980
Total Depth;	3805'
Casing;	8 5/8 @ 1006 w/450 sx.
Production;	D & A

Figures Indicate Bottom Of Formations;

422	Surface hole
685	Shale
995	Shale
1001	Anhy
1165	Shale
1835	Shale
2565	Shale & lime
3240	Lime & shale
3615	Lime & shale
3727	Lime & shale
3799	Lime
3805	Arbuckle

I certify the above to be a true and correct copy of the drillers log to the best of my knowlege and belief.

Woodman & Iannitti Drilling Co.

K. T. Woodman
 K. T. Woodman

RECEIVED
 STATE CORPORATION COMMISSION

NOV - 4 1980

CONSERVATION DIVISION
 Wichita, Kansas