


WELL PLUGGING RECORD

Give All Information Completely
Make Required Affidavit
Mail or Deliver Report to:
Conservation Division
State Corporation Commission
211 No. Broadway
Wichita, Kansas

Pawnee County, Sec. 5 Twp. 21S Rge. 16 (X) (W)

Location as "NE/CNW/SW" or footage from lines SW SW NE
Lease Owner Dunne-Gardner Drilling Co., Inc.
Lease Name Bradley Well No. 1
Office Address 300 Schweiter Building, Wichita, Kansas
Character of Well (completed as Oil, Gas or Dry Hole) Dry Hole
Date well completed October 5, 19 63
Application for plugging filed October 7, 19 63
Application for plugging approved 19 63
Plugging commenced October 5, 19 63
Plugging completed October 5, 19 63
Reason for abandonment of well or producing formation dry hole

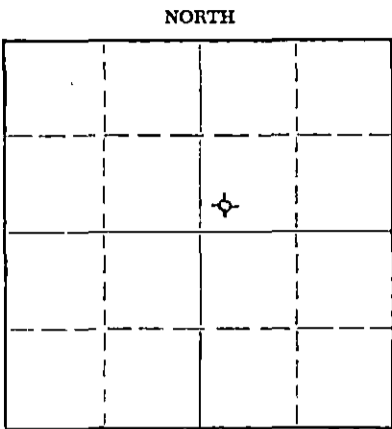

Locate well correctly on above Section Plat

If a producing well is abandoned, date of last production 19
Was permission obtained from the Conservation Division or its agents before plugging was commenced? yes

Name of Conservation Agent who supervised plugging of this well Eldon Petty
Producing formation _____ Depth to top _____ Bottom _____ Total Depth of Well 3822 Feet
Show depth and thickness of all water, oil and gas formations.

OIL, GAS OR WATER RECORDS

CASING RECORD

FORMATION	CONTENT	FROM	TO	SIZE	PUT IN	PULLED OUT
Surface Pipe		-0-	1035	8-5/8"	9-29-63	None

Describe in detail the manner in which the well was plugged, indicating where the mud fluid was placed and the method or methods used in introducing it into the hole. If cement or other plugs were used, state the character of same and depth placed, from _____ feet to _____ feet for each plug set.

Filled hole with heavy mud to 420' from surface; set plug and 20 sacks cement; filled surface pipe with heavy mud to 180' from surface; set plug, 1/4 sack hulls and 20 sacks cement; heavy mud to 30' from surface; set plug and 10 sacks cement.

10-8-63

RECEIVED
STATE CORPORATION COMMISSION

OCT 8 1963

CONSERVATION DIVISION
Wichita, Kansas

(If additional description is necessary, use BACK of this sheet)

Name of Plugging Contractor _____
Address _____

STATE OF KANSAS, COUNTY OF SEDGWICK, ss.

Don Gardner (employee of owner) of the above-described well, being first duly sworn on oath, says: That I have knowledge of the facts, statements, and matters herein contained and the log of the above-described well as filed and that the same are true and correct. So help me God.

(Signature) [Signature]
300 Schweiter Building, Wichita, Kansas
(Address)

SUBSCRIBED AND SWORN TO before me this 7th day of October, 19 63

My commission expires November 9, 1965

Marilyn E. Fox
Marilyn E. Fox Notary Public.

DRILLER'S LOG

OPERATOR: Dunne-Gardner Drilling Co., Inc.
300 Schweiter Building, Wichita, Kansas

LEASE: Bradley

WELL: No. 1

LOCATION: SW SW NE Sec. 5-21S-16W,
Pawnee County, Kansas

DATE COMMENCED: September 27, 1963

DATE COMPLETED: October 5, 1963

TOTAL DEPTH: 3822

CASING: Set 1047' of 8-5/8" surface pipe at 1035' w/450 sacks
of cement.

<u>FROM</u>	<u>TO</u>	
0	245	Shale and surface clay
245	470	Clay
470	585	Sand
585	705	Red Bed
705	1025	Red Bed and Shale
1025	1047	Anhydrite
1047	1470	Sand and Shale
1470	1995	Shale
1995	2155	Lime and Shale
2155	2186	Sand
2186	2220	Lime and Shale
2220	2340	Lime
2340	2743	Lime and Shale
2743	2900	Shale
2900	3539	Lime and Shale
3539	3822	Lime
	3822	Total Depth

RECEIVED
STATE CORPORATION COMMISSION

OCT 8 1963

CONSERVATION DIVISION
Wichita, Kansas

I certify the above to be true and correct to the best of my knowledge and belief.


DUNNE-GARDNER DRILLING CO., INC.

By 

Don Gardner

Subscribed and sworn to before me this 7th day of October, 1963.

My Commission Expires: November 9, 1963

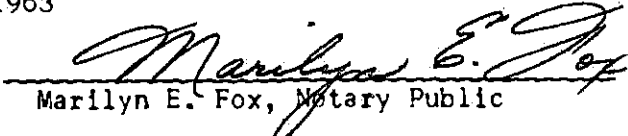
Marilyn E. Fox, Notary Public