


STATE OF KANSAS  
STATE CORPORATION COMMISSION

WELL PLUGGING RECORD

Give All Information Completely  
Make Required Affidavit  
Mail or Deliver Report to  
Conservation Division  
State Corporation Comm.  
245 North Water  
Wichita, KS 67202

Pawnee County, Sec. 5 Twp. 21S Rge. 16W E/W  
Location as "NE/CNW $\frac{1}{4}$ SW $\frac{1}{4}$ " or footage from lines  
SW SE

Lease Owner Mid America Producers Inc.  
Lease Name Bradley #1 Well No. \_\_\_\_\_  
Office Address Box 18163, Oklahoma City, Ok. 73154  
Character of Well (Completed as Oil, Gas or Dry Hole) \_\_\_\_\_

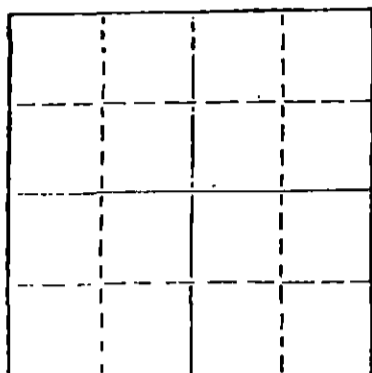

Locate well correctly on above  
Section Plat

Date Well completed \_\_\_\_\_ 19\_\_\_\_  
Application for plugging filed \_\_\_\_\_ 19\_\_\_\_  
Application for plugging approved \_\_\_\_\_ 19\_\_\_\_  
Plugging commenced 4/28/81 \_\_\_\_\_ 19\_\_\_\_  
Plugging completed 4/30/81 \_\_\_\_\_ 19\_\_\_\_

Reason for abandonment of well or producing formation \_\_\_\_\_  
Depleted  
If a producing well is abandoned, date of last production \_\_\_\_\_ 19\_\_\_\_

Was permission obtained from the Conservation Division or  
its agents before plugging was commenced? Yes

Name of Conservation Agent who supervised plugging of this well Marion Schmidt  
Producing formation \_\_\_\_\_ Depth to top \_\_\_\_\_ Bottom \_\_\_\_\_ Total Depth of Well 2567'  
Show depth and thickness of all water, oil and gas formations.

OIL, GAS OR WATER RECORDS

CASING RECORD

FORMATION	CONTENT	FROM	TO	SIZE	PUT IN	PULLED OUT
				8-5/8"	1028	None
				4 1/2"	2547	1835'

Describe in detail the manner in which the well was plugged, indicating where the mud fluid  
was placed and the method or methods used in introducing it into the hold. If cement or other  
plugs were used, state the character of same and depth placed, from \_\_\_\_\_ feet to  
\_\_\_\_\_ feet for each plug set.

Moved in and rigged up. Made bottom hole plug back with sand to 2000' and ran 4 sacks cement.  
Made shots at 1895 and 1830. Pulled total of 56 joints. Squeezed hole with 5 sacks hulls  
and 10 sacks gel. Released plug and displaced with 140 sacks 50/50 pos 6% gel 3% cc.  
Plugging complete.

RECEIVED  
STATE CORPORATION COMMISSION  
3-5-81  
MAY 25 1981  
CONSERVATION DIVISION  
Wichita, Kansas

(If additional description is necessary, use BACK of STATE sheet 25 1981)  
Name of Plugging Contractor KELSO CASING PULLING

STATE OF Kansas COUNTY OF Rice  
R. Darrell Kelso (employee of owner) or (owner or operator)  
of the above-described well, being first duly sworn on oath, says: That I have knowledge of  
the facts, statements, and matters herein contained and the log of the above-described well  
as filed and that the same are true and correct. So help me God.

(Signature) R. Darrell Kelso  
Chase, Kansas (Address)

SUBSCRIBED AND SWORN TO before me this 4th day of May, 1981

My commission expires



Joan Kelso  
Notary Public.

# MID-WEST PETROLEUM MANAGEMENT

L. H. 'DUTCH' WALTERS  
Petroleum Bldg., Suite 210  
Wichita, Kansas 67202  
316 - 265-0513

Property Management  
Evaluations

Well Completion  
Registered Engineer

Kelso Casing Pulling  
Box #176  
Chase, Kansas 67524

Operator  
Mid-America Producers, Inc.  
Box #18163  
Olahoma City, Oklahoma 73154

Re: Bradley #1  
SWSE Sec. 5-21w-16w  
Pawnee County, Kansas

- 1/13/81 8 5/8" casing at 1028'
- 1/17/81 4 1/2" 9.5# new casing at 2547' Cemented with 150 sacks 60/40 Pozmix, 10% salt saturated.
- 1/28/81 Perforations 2088'-94'.
- 1/29/81 CI bridge plug 2080'. Perforations 2024'-32'.
- 1/30/81 Released rig. No show.

Drilling contractor  
ROCO Drilling Co.  
Box #1162  
Great Bend, Kansas 67530

RECEIVED  
STATE OF KANSAS  
MAY 1981  
CONSULTING DIVISION  
Wichita, Kansas