


WELL PLUGGING RECORD
OR 15-009-06361-0890
FORMATION PLUGGING RECORD

Strike out upper line
when reporting plug-
ging of formations.

Give All Information Completely
Make Required Affidavit
Mail or Deliver Report to:
Conservation Division
State Corporation Commission
800 Biting Building
Wichita, Kansas

Barton County. Sec. 8 Twp. 16S. Rge. (E) 12. (W)
Location as "NE $\frac{1}{4}$ NW $\frac{1}{4}$ SW $\frac{1}{4}$ " or footage from lines CS $\frac{1}{2}$ SE $\frac{1}{2}$ NW $\frac{1}{2}$
Lease Owner Darby Petroleum Corporation
Lease Name Staudinger Well No. 1
Office Address 1015 Philtower, Tulsa, Oklahoma
Character of Well (Completed as Oil, Gas or Dry Hole) Dry
Date, well completed May 25, 1943 193
Application for plugging filed May 26, 1943 193
Application for plugging approved June 2, 1943 193
Plugging Commenced May 26, 1943 193
Plugging Completed May 26, 1943 193
Reason for abandonment of well or producing formation Dry hole

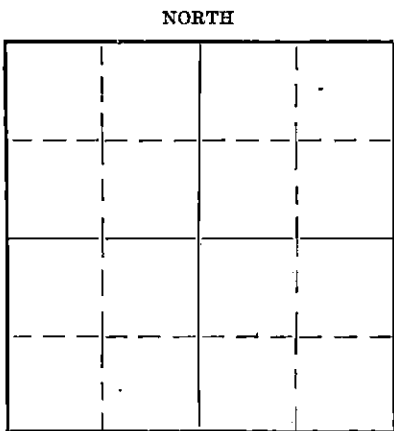

Locate well correctly on above
Section Plat

If a producing well is abandoned, date of last production 193
Was permission obtained from the Conservation Division or its agents before plugging was com-
menced? Yes

Name of Conservation Agent who supervised plugging of this well G. T. Alexander
Producing formation None Depth to top Bottom Total Depth of Well 3349 Feet
Show depth and thickness of all water, oil and gas formations.

OIL, GAS OR WATER RECORDS


CASING RECORD

Formation	Content	From	To	Size	Put In	Pulled Out
				10"	814'	None

Describe in detail the manner in which the well was plugged, indicating where the mud fluid was placed and the method or methods used in introducing it into the hole. If cement or other plugs were used, state the character of same and depth placed, from feet to feet for each plug set.

Filled with mud from 3349' to 814', cement plug set
814' to 764' with 25 sacks of cement. Filled with
mud 764' to 75'. Plugged with 38 sacks of cement
from 75' to surface.

PLUGGING
FILE SEC 8-16-R12-10
BOOK PAGE 76 LINE 1

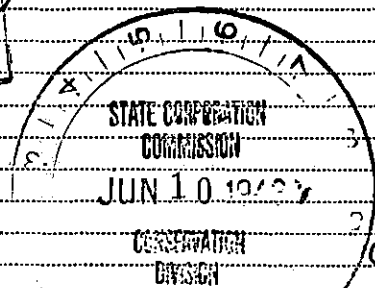

06-10-43

Joseph W. Mack

(If additional description is necessary, use BACK of this sheet)

Correspondence regarding this well should be addressed to Darby Petroleum Corporation
Address 1015 Philtower, Tulsa, Oklahoma

STATE OF Oklahoma, COUNTY OF Tulsa, ss.
Frank Albert (employee of owner)

being first duly sworn on oath, says: That I have knowledge of the facts, statements, and matters herein contained and the log of the above-described well as filed and that the same are true and correct. So help me God.

(Signature) *Frank Albert*

1015 Philtower, Tulsa, Oklahoma
(Address)

SUBSCRIBED AND SWORN to before me this 8th day of June, 1943.

J. E. Waibel

My commission expires March 1, 1946.

FORMATION RECORD

	<u>FROM</u>	<u>TO</u>
Shale & shells	0	80
Sand	80	150
Shale & shells	150	811
Anhydrite	811	830
Shale & shells	830	1110
Shale & salt	1110	1335
Shale & shells	1335	1635
Shale & lime	1635	1940
Lime	1940	2035
Lime & shale	2035	2340
Shale	2340	2670
Lime	2670	3009
Shale	3009	3080
Lime	3080	3331
Sand	3331	3335
Lime	3335	3349 T.D.