


15-009 - 06719-8000
WELL PLUGGING RECORD

Give All Information Completely
Make Required Affidavit
Mail or Deliver Report to:
Conservation Division
State Corporation Commission
211 No. Broadway
Wichita, Kansas

BARTON County. Sec. 8 Twp. 16 Rge. 12 (E) W (W)

NORTH

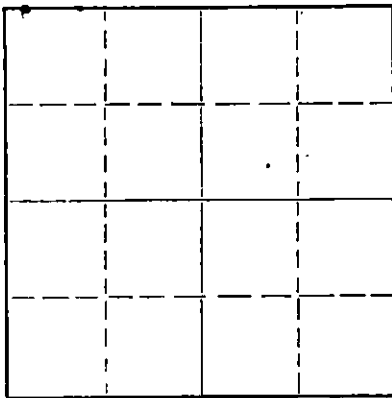

Locate well correctly on above Section Plat

Location as "NE/CNW%SW%" or footage from lines NW SE NE
Lease Owner Harms Drilling Company & Fair
Lease Name Bieberle Well No. 1
Office Address Box 488 Great Bend, Kansas
Character of Well (completed as Oil, Gas or Dry Hole) Dry Hole
Date well completed January 4 19 64
Application for plugging filed January 4 19 64
Application for plugging approved January 4 (verbally) 19 64
Plugging commenced January 4 19 64
Plugging completed January 4 19 64
Reason for abandonment of well or producing formation _____

If a producing well is abandoned, date of last production _____ 19____
Was permission obtained from the Conservation Division or its agents before plugging was commenced? Yes

Name of Conservation Agent who supervised plugging of this well Donald Truan
Producing formation _____ Depth to top _____ Bottom _____ Total Depth of Well 3360 Feet
Show depth and thickness of all water, oil and gas formations.

OIL, GAS OR WATER RECORDS

CASING RECORD

FORMATION	CONTENT	FROM	TO	SIZE	PUT IN	PULLED OUT
Surface		0	213'	8 5/8"	213'	none

Describe in detail the manner in which the well was plugged, indicating where the mud fluid was placed and the method or methods used in introducing it into the hole. If cement or other plugs were used, state the character of same and depth placed, from _____ feet to _____ feet for each plug set.

Filled hole with heavy mud from total depth to 350' with plug and 20 sacks of cement at this point. Heavy mud to 200' with plug, 1/4 sack of hulls, and 20 sacks of cement at this point. Heavy mud to 40' with plug, 1/4 sack hulls and 10 sacks of cement at this point.

RECEIVED
STATE CORPORATION COMMISSION
01-27-64 JAN 27 1964

CONSERVATION DIVISION
Wichita, Kansas

(If additional description is necessary, use BACK of this sheet)
Name of Plugging Contractor Harms Drilling Company
Address Box 488 Great Bend, Kansas

STATE OF KANSAS, COUNTY OF BARTON, ss.
Allan Harms (employee of owner) or (owner or operator) of the above-described well, being first duly sworn on oath, says: That I have knowledge of the facts, statements, and matters herein contained and the log of the above-described well as filed and that the same are true and correct. So help me God.

(Signature) Allan Harms
Box 488 Great Bend, Kansas
(Address)

SUBSCRIBED AND SWORN TO before me this 24th day of January, 1964

My commission expires January 22, 1966

Helen E. Gearhart
Helen E. Gearhart
Notary Public.

