


STATE OF KANSAS
STATE CORPORATION COMMISSION

WELL PLUGGING RECORD

Give All Information Completely
Make Request on Affidavit
Mail or Deliver Report to:
Conservation Division
State Corporation Commission
800 Bitting Building
Wichita, Kansas

Pawnee County. Sec. 22 Twp. 21S Rge. (E) 16(W)

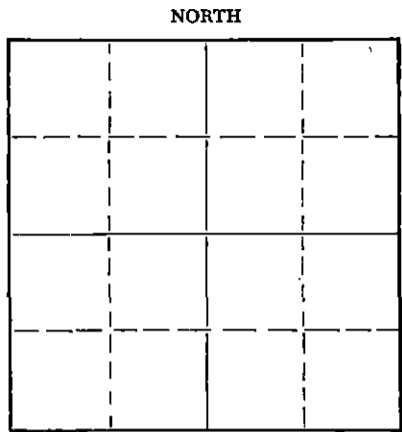

Locate well correctly on above Section Plat

Location as "NE/CNWKSWK" or footage from lines NE SE SE
Lease Owner Petroleum, Inc.
Lease Name HUNSLEY Well No. 2
Office Address 311 East Third, Wichita, Kansas
Character of Well (completed as Oil, Gas or Dry Hole) Dry Hole
Date well completed April 28 19 55
Application for plugging filed April 28 19 55
Application for plugging approved April 28 19 55
Plugging commenced April 28 19 55
Plugging completed April 28 19 55
Reason for abandonment of well or producing formation Dry Hole

If a producing well is abandoned, date of last production 19
Was permission obtained from the Conservation Division or its agents before plugging was commenced? Yes

Name of Conservation Agent who supervised plugging of this well Mr. M. A. Rives
Producing formation Depth to top Bottom Total Depth of Well 3905 Feet
Show depth and thickness of all water, oil and gas formations.

OIL, GAS OR WATER RECORDS

CASING RECORD

FORMATION	CONTENT	FROM	TO	SIZE	PUT IN	PULLED OUT
				8-5/8"	987'	None

Describe in detail the manner in which the well was plugged, indicating where the mud fluid was placed and the method or methods used in introducing it into the hole. If cement or other plugs were used, state the character of same and depth placed, from feet to feet for each plug set.

Mudded up to 300' set first wooden plug at 300'.

Placed 1 1/2 gal. hulls on top of plug. Displaced 20 sacks cement through drill pipe on top of hulls. Mudded up to 35' and set second wooden plug at 35', 1/4 sacks hulls on top of plug. Filled hole with 10 sacks cement to base of well cellar.

5-14-55
STATE CORPORATION COMMISSION
MAY 14 1955
CONSERVATION DIVISION
Wichita, Kansas

(If additional description is necessary, use BACK of this sheet)

Name of Plugging Contractor Garvey Drilling Company
Address R. R. #2, Great Bend, Kansas

STATE OF KANSAS, COUNTY OF SEDGWICK, ss.
Karl E. Becker (employee of owner) or (owner or operator) of the above-described well, being first duly sworn on oath, says: That I have knowledge of the facts, statements, and matters herein contained and the log of the above-described well as filed and that the same are true and correct. So help me God.

(Signature) Karl E. Becker
311 East Third, Wichita, Kansas
(Address)

SUBSCRIBED AND SWORN TO before me this 4th day of May, 19 55

My commission expires 8-11-58 Notary Public.

PLUGGING
FILE SEC 22 T 21 R 16W
BOOK PAGE 115 LINE 40

WELL LOG

COMPANY Petroleum, Inc.

SEC. 22 T. 21S R. 16W

FARM HUNSLEY

NO. 2

LOC. NE SE SE

TOTAL DEPTH 3905'


COUNTY Pawnee

COMM. April 15, 1955

COMP. April 28, 1955

CONTRACTOR Garvey Drilling Company

CASING 8-5/8" @ 987 w/450 sax

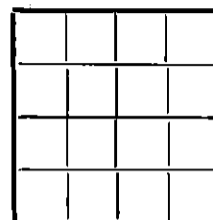

ELEVATION 1985 RB

PRODUCTION D & A

FIGURES INDICATE BOTTOM OF FORMATIONS

120	Sand
355	Shale and Shells
425	Shale
475	Soft Sand
520	Medium Sand
600	Shale and Shells
725	Shale, Shells and Red Bed
979	Red Bed Shale
987	Plug and Cement
1000	Anhydrite
1007	Anhydrite Lime
1500	Red Rock, Shale and Shells
1585	Red Rock and Shale
2010	Shale and Lime
2310	Lime
2470	Lime and Shale
2530	Lime
3150	Lime and Shale
3725	Lime
3787	Lime and Chert
3830	Chert and Shale
3870	Shale and Lime
3885	Lime
3905	Arbuckle

Tops

Heebner:	3384 (-1399)
Toronto:	3404 (-1419)
Brown Lime:	3481 (-1496)
Lansing:	3492 (-1507)
Conglomerate:	3761 (-1776)
Simpson:	3874 (-1889)
Arbuckle:	3880 (-1895)

R.T.D. 3905'

RECEIVED
STATE CORPORATION COMMISSION
MAY 14 1955
CONSERVATION DIVISION
Wichita, Kansas

State of KANSAS }
County of SEDGWICK } ss:

I, Karl E. Becker of Petroleum, Inc. PAGE 15 LINE 40

upon oath state that the above and foregoing is a true and correct copy of the log of the HUNSLEY #2 well

Karl E. Becker

Subscribed and sworn to before me this 13th day of May 1955

My Commission Expires: 8-11-58

[Signature]
NOTARY PUBLIC