


Give All Information Completely
Make Required Affidavit
Mail or Deliver Report to:
Conservation Division
State Corporation Commission
211 No. Broadway
Wichita, Kansas

WELL PLUGGING RECORD

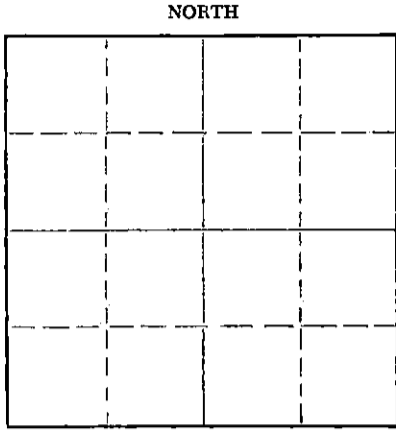

Locate well correctly on above
Section Plat

Pawnee County, Sec. 22 Twp. 21S Rge. 16W (X) (W)
Location as "NE/CNW/SW" or footage from lines SW $\frac{1}{4}$ SE $\frac{1}{4}$ SW $\frac{1}{4}$
Lease Owner El Dorado Refining Company
Lease Name Hunsley Well No. 1
Office Address 1020 Central Building, Wichita, Kansas.
Character of Well (completed as Oil, Gas or Dry Hole) Dry Hole
Date well completed 11-24-57 19
Application for plugging filed 11-24-57 19
Application for plugging approved 11-24-57 19
Plugging commenced 11-24-57 19
Plugging completed 11-24-57 19
Reason for abandonment of well or producing formation Dry Hole

If a producing well is abandoned, date of last production - 19
Was permission obtained from the Conservation Division or its agents before plugging was commenced? Yes

Name of Conservation Agent who supervised plugging of this well Don Truan
Producing formation _____ Depth to top _____ Bottom _____ Total Depth of Well _____ Feet
Show depth and thickness of all water, oil and gas formations.

OIL, GAS OR WATER RECORDS

CASING RECORD

FORMATION	CONTENT	FROM	TO	SIZE	PUT IN	PULLED OUT
				8 5/8"	976'	

Describe in detail the manner in which the well was plugged, indicating where the mud fluid was placed and the method or methods used in introducing it into the hole. If cement or other plugs were used, state the character of same and depth placed, from _____ feet to _____ feet for each plug set.

1st Plug @ 450' with 20 sacks cement through drillpipe
2nd Plug @ 240' with 20 sacks cement
Top Plug @ 40' with 10 sacks cement to bottom cellar.

(If additional description is necessary, use BACK of this sheet)
Name of Plugging Contractor Leben Drilling, Inc. 12-5-57
Address 905 Central Building, Wichita, Kansas

STATE OF Kansas, COUNTY OF Sedgwick
Frank Hamlin (employee of Leben Drilling, Inc. or owner) of the above-described well, being first duly sworn on oath, says: That I have knowledge of the facts, statements, and matters herein contained and the log of the above-described well as filed and that the same are true and correct. So help me God.

(Signature) Frank Hamlin
905 Central Building, Wichita, Kansas (Address)

SUBSCRIBED AND SWORN TO before me this 3rd day of December, 19 57

My commission expires June 17, 1961
Ruth N. Benjamin Notary Public.

PLUGGING
FILE SEC. 22 T. 21 R. 16W
BOOK PAGE 65 LINE 24

DRILLER'S LOG

COMPANY:
CONTRACTOR:
FARM:
LOCATION:
COMMENCED:
COMPLETED:

COLORADO REFINING CO.
LEBEN DRILLING, INC.
HUNSLEY #1
SW SE SW SEC. 22-21S-16W
PAWNEE COUNTY, KANSAS
11-11-57
11-24-57

0	10	Surface Soil
10	95	Sand
95	130	Sand & Shale
130	375	Shale & Hard Sand
375	405	Shale
405	520	Sand
520	660	Shale & Shells
660	850	Shale, Shells, & Red Bed
850	970	Shale & Shells
970	1005	Anhydrite
1005	1855	Shale & Shells
1855	2280	Lime & Shale
2280	2465	Lime
2465	2875	Shale & Lime
2875	3240	Lime
3240	3445	Lime
3445	3510	Shale & Lime
3510	3552	Lime
3552	3577	Soft Lime & Shale
3577	3855	Lime
3855	3880	Lime
		<u>ROTARY TOTAL DEPTH - D. & A.</u>

Set 976' of 8 5/8" surface casing with 475 sacks cement and 2% CaCl₂.

I, Frank Hamlin, do hereby certify that the above and foregoing is a true and correct copy of the log of the Hunsley #1, located SW SE SW of Section 22, Township 21 South, Range 16 West, Pawnee County, Kansas, as reflected by the files of Leben Drilling, Inc.

LEBEN DRILLING, INC.

By: Frank Hamlin
Frank Hamlin

STATE OF KANSAS)
COUNTY OF SEDGWICK) SS

Subscribed and sworn to before me, a Notary Public, in and for Sedgwick County, Kansas, this 3rd day of December, 1957.

Ruth H. Benjamin
Ruth H. Benjamin, Notary Public

My Commission Expires:
June 17, 1961.

STATE OF KANSAS)
COUNTY OF SEDGWICK)
DEC 5 1957

CONSERVATION DIVISION
Wichita, Kansas

PLUGGING
FILE SEC. 22 T. 21 R. 16W
BOOK PAGE 65 LINE 24