


COPY

WELL PLUGGING RECORD

Give All Information Completely
Make Required Affidavit
Mail or Deliver Report to:
Conservation Division
State Corporation Commission
800 Bitting Building
Wichita, Kansas

NORTH

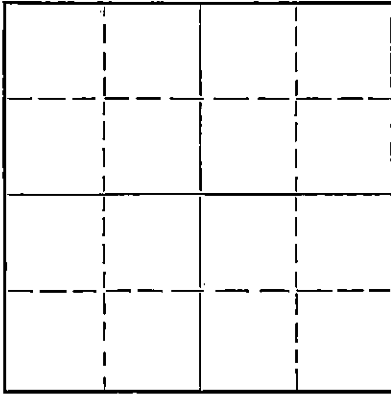

Locate well correctly on above
Section Plat

Pawnee County, Sec. 22 Twp 21S Rge 16 (X) (W)
Location as "NE/CNW $\frac{1}{4}$ SW $\frac{1}{4}$ " or footage from lines C S/2 SW/4 NE/4
Lease Owner S. T. Jocelyn et al
Lease Name Lawton Well No. 1
Office Address 1106 Union National Bank Bldg., Wichita, Kansas
Character of Well (completed as Oil, Gas or Dry Hole) Dry Hole
Date well completed May 27 19 53
Application for plugging filed May 27 19 53
Application for plugging approved May 27 19 53
Plugging commenced May 28 19 53
Plugging completed May 28 19 53
Reason for abandonment of well or producing formation Dry Hole

If a producing well is abandoned, date of last production 19
Was permission obtained from the Conservation Division or its agents before plugging was commenced? Yes

Name of Conservation Agent who supervised plugging of this well M. A. Rives
Producing formation Depth to top Bottom Total Depth of Well 3900 Feet
Show depth and thickness of all water, oil and gas formations.

OIL, GAS OR WATER RECORDS

CASING RECORD

Formation	Content	From	To	Size	Put In	Pulled Out
				8-5/8"	990'	0

Describe in detail the manner in which the well was plugged, indicating where the mud fluid was placed and the method or methods used in introducing it into the hole. If cement or other plugs were used, state the character of same and depth placed, from feet to feet for each plug set.

Filled hole with heavy mud when half of drill pipe was down. Finished laying down pipe. Set bottom plug at 270'. Cemented with 20 sacks through drill pipe. Laid down rest of pipe. Filled hole to 40' with mud. Set top plug at 40'. Cemented with 10 sacks.

RECEIVED
STATE CORPORATION COMMISSION
JUN 2 1953
CONSERVATION DIVISION
Wichita, Kansas

6-2-53

(If additional description is necessary, use BACK of this sheet)
Name of Plugging Contractor Sterling Drilling Company
Address 304 N. Broadway, Sterling, Kansas

STATE OF Kansas, COUNTY OF Rice, ss.
F. A. Wuellner (employee of owner) of the above-described well,
being first duly sworn on oath, says: That I have knowledge of the facts, statements, and matters herein contained and the log of the above-described well as filed and that the same are true and correct. So help me God.

(Signature) *F. A. Wuellner*
304 N. Broadway, Sterling, Kansas
(Address)

SUBSCRIBED AND SWORN to before me this 28 day of May, 19 53

My commission expires June 2, 56
Wm. M. Pearson
Notary Public.

23-8390-s 6-51-20M
PLUGGING
FILE SEC 22 T 21 R 16
BOOK PAGE 104 LINE 1E

STERLING DRILLING CO.

STERLING, KANSAS

WELL LOG ----- J. N. LAWTON #1

Location - C S/2 SW/4 NE/4 Section 22-21S-16W, Pawnee County, Kansas

Owner - S. T. Jocelyn et al
Rotary Drilling Contractor - Sterling Drilling Company

Commenced - 5-15-53
Completed - 5-27-53

Total Depth - 3900'

LOG

0- 160	Sand
160- 420	Shale
420- 550	Sand
550- 985	Shale and Red Bed
985- 990	Anhydrite
990-1700	Shale and Shells
1700-1995	Lime and Shale
1995-2125	Lime
2125-2860	Lime and Shale
2860-2935	Lime
2935-3200	Lime and Shale
3200-3260	Lime
3260-3320	Lime and Shale
3320-3373	Lime
3373-3482	Shale and Lime
3482-3520	Lime - Lansing
3520-3710	Lime
3710-3765	Lime and Shale
3765-3814	Lime
3814-3860	Lime, Shale and Sand
3860-3867	Simpson Sand
3867-3876	Arbuckle Lime
3876-3900	Lime

CASING RECORD

1004' of 8-5/8" Surface Pipe
Cemented with 500 sacks Cement

PRODUCTION: Dry and Abandoned

RECEIVED
STATE COMMISSION
JUN 1953
CONSERVATION DIVISION
Wichita, Kansas

THIS IS TO CERTIFY that the above is a true and correct record of the drillers' Log of the J. N. Lawton #1 well.

(Signed) STERLING DRILLING COMPANY

By F. A. Wuellner
F. A. Wuellner - Sec'y-Treasurer

PLUGGING
FOR SEC 22-21S-16W
WELL PAGE 104 LINE 11