


WELL PLUGGING RECORD

Give All Information Completely
Make Required Affidavit
Mail or Deliver Report to:
Conservation Division
State Corporation Commission
212 North Market, Insurance Bldg.
Wichita, Kansas

NORTH

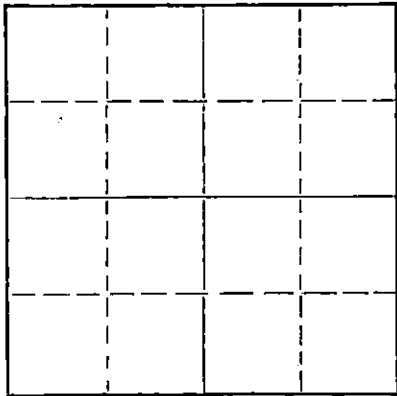

Locate well correctly on above Section Plat

Finney County. Sec. 5 Twp. 21S Rge. 31W (~~23~~) (W)
Location as "NE/CNW%SW%" or footage from lines C NE NE
Lease Owner Pet-Ex Company
Lease Name Breyfogle Well No. 1
Office Address 705 Union Center, Wichita, Kansas
Character of Well (completed as Oil, Gas or Dry Hole) D & A
Date well completed February 20, 1961
Application for plugging filed February 20, 1961
Application for plugging approved February 20, 1961
Plugging commenced February 20, 1961
Plugging completed February 20, 1961
Reason for abandonment of well or producing formation D & A

If a producing well is abandoned, date of last production _____ 19____
Was permission obtained from the Conservation Division or its agents before plugging was commenced? Yes

Name of Conservation Agent who supervised plugging of this well Frank Broadfoot
Producing formation _____ Depth to top _____ Bottom _____ Total Depth of Well _____ Feet
Show depth and thickness of all water, oil and gas formations.

OIL, GAS OR WATER RECORDS

CASING RECORD

FORMATION	CONTENT	FROM	TO	SIZE	PUT IN	PULLED OUT
				8 5/8"	279'	-0-

Describe in detail the manner in which the well was plugged, indicating where the mud fluid was placed and the method or methods used in introducing it into the hole. If cement or other plugs were used, state the character of same and depth placed, from _____ feet to _____ feet for each plug set.

Filled hole with heavy mud to 240'. Set bottom plug with 1/2 sx hulls and 20 sx cement. Set top plug at 35' with 1/2 sx hulls and 10 sx cement

6-20-61

RECEIVED
STATE CORPORATION COMMISSION

JUN 20 1961

CONSERVATION DIVISION
Wichita, Kansas

(If additional description is necessary, use BACK of this sheet)
Name of Plugging Contractor Red Tiger Drilling Company
Address Box 173, Russell, Kansas

STATE OF KANSAS, COUNTY OF SEDGWICK, ss.
George A. Angle (~~employee of owner~~) or (owner or operator) of the above-described well, being first duly sworn on oath, says: That I have knowledge of the facts, statements, and matters herein contained and the log of the above-described well as filed and that the same are true and correct. So help me God.

(Signature) George A. Angle
580 Fourth Nat Bank Bldg., Wichita, Ks.
(Address)

SUBSCRIBED AND SWORN TO before me this 21st day of February, 1961

Wapner Head
Notary Public.

My commission expires 11-17-62

R

DRILLING LOG

Brayfogle No. 1

CASING RECORD: COMPANY: Pet-Ek Company DESCRIPTION: C NE NE
 8 3/8" @ 270' CONTRACTOR: Red Tiger Drilling Co. S-214-319
 w/210 sz cement FINNEY COUNTY
 KANSAS
 COMMENCED: February 5, 1961 ELEVATION:
 COMPLETED: February 20, 1961

Total Depth: 4820'

<u>FORMATION</u>	<u>FROM</u>	<u>TO</u>	<u>REMARKS</u>
Soil	0	5	
Clay & Sand	5	35	
Shale	35	220	
Shale	220	276	
Shale Shells	276	1010	
Sand	1010	1085	
Shale & Shells	1085	1385	
Red Red & Shale	1385	1575	
Lime Anhydrite	1575	1610	
Shale & Shells	1610	2150	
anhydrite	2150	2195	
Shale Shells	2195	2515	
Shale & Lime	2515	2600	
Lime Shale	2600	3195	
Lime	3195	3257	
Lime Shale	3257	4215	
Lime	4215	4600	
Lime Shale	4600	4681	
Lime	4681	4820	

I certify that this is a true and correct copy of the above log to the best of my knowledge.

RED TIGER DRILLING COMPANY

George A. Angle
 George A. Angle

Subscribed and sworn to before me this 21st day of February, 1961.

Minnie Head
 Notary Public

My Commission Expires:

11-17-63

RECEIVED
 STATE CORPORATION COMMISSION
 JUN 21 1961
 CONSERVATION DIVISION
 Wichita, Kansas