


STATE OF KANSAS
STATE CORPORATION COMMISSION

All Information Completely
Required Affidavit
Mail or Deliver Report to:
Conservation Division
State Corporation Commission
800 Bitting Building
Wichita, Kansas

WELL PLUGGING RECORD

NORTH

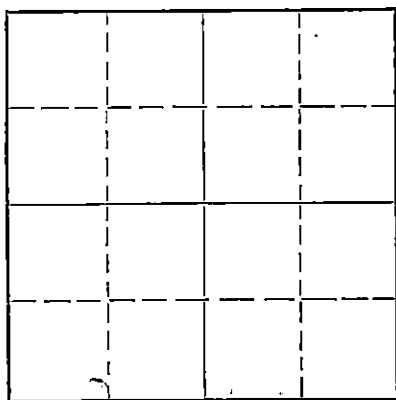

Locate well correctly on above
Section Plat

Pawnee County, Sec. 17 Twp. 21S Rge. 16 (E) W (W)
Location as "NE/CNW/SW" or footage from lines SE SE NW
Lease Owner Trans Era Petroleum, Inc.
Lease Name DeRoo Well No. 1
Office Address Russell, Kansas
Character of Well (completed as Oil, Gas or Dry Hole) Dry
Date well completed 1/28/54 19
Application for plugging filed 1/27/54 19
Application for plugging approved 1/27/54 19
Plugging commenced 1/28/54 19
Plugging completed 1/28/54 19
Reason for abandonment of well or producing formation Dry Hole

If a producing well is abandoned, date of last production 19
Was permission obtained from the Conservation Division or its agents before plugging was commenced? Yes

Name of Conservation Agent who supervised plugging of this well M. A. Rives
Producing formation Depth to top Bottom Total Depth of Well 3850 Feet
Show depth and thickness of all water, oil and gas formations.

OIL, GAS OR WATER RECORDS

CASING RECORD

FORMATION	CONTENT	FROM	TO	SIZE	PUT IN	PULLED OUT
				8 5/8"	1004"	None

Describe in detail the manner in which the well was plugged, indicating where the mud fluid was placed and the method or methods used in introducing it into the hole. If cement or other plugs were used, state the character of same and depth placed, from feet to feet for each plug set.

Plugging Record

Layed down drill pipe. Filled hole with heavy mud to 300'. Mixed and poured 20 sacks cement through drill pipe. Filled hole with mud to 40', set top plug at 40' with 10 sacks of cement.

RECEIVED
STATE CORPORATION COMMISSION
FEB 6 - 1954

(If additional description is necessary, use BACK of this sheet)

Name of Plugging Contractor
Address 2-6-54


STATE OF KANSAS, COUNTY OF RUSSELL, ss.
H. R. Michaelis (employee of owner) or (owner or operator) of the above-described well, being first duly sworn on oath, says: That I have knowledge of the facts, statements, and matters herein contained and the log of the above-described well as filed and that the same are true and correct. So help me God.

(Signature) H. R. Michaelis
Russell, Kansas
(Address)

SUBSCRIBED AND SWORN to before me this 4th day of February, 19 54

My commission expires 1-30-57.

Margie Cooper
Notary Public.

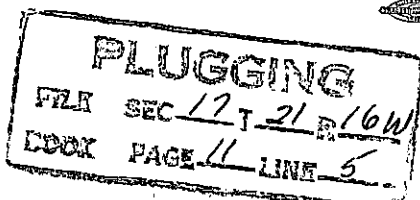

Trans Era Petroleum, Inc.
De Roo #1

SE SE NW 17-21S-16W
Pawnee County, Ks.

Total Depth 3850'
Comm. 1/11/54
Comp. 1/28/54

Casing

Cement

8 5/8" Set @ 1004'

550 sacks of Comm.

Formation	Depth
Clay	20
Sand-gravel	140
Shale-shells	420
Sand	560
Shale-red bed	993
Anhydrite	1020
Red bed	1125
Red bed-shale	1280
Shale-shells	1540
Salt-shale	1720
Lime-shale	3289
Lime	3332
Lime-shale	3473
Lime	3526
Lime-shale	3593
Lime	3722
Shale-lime	3772
Conglomerate	3777
Shale-sand	3798
Arbuckle	3805
Lime	3831
Lime-shale	3850'

STATE OF KANSAS)
) ss
RUSSELL COUNTY)

I hereby certify that the above information is true and correct to the best of my knowledge.

Cora Beth

Subscribed and sworn to before me this 4th day of February, 1954.

Margie Cooper
Notary Public

My commission expires: 1-30-57.

PLUGGING
FILE SEC 17 T 21 R 16W
BOOK PAGE 11 LINE 5