


WELL PLUGGING RECORD

Give All Information Completely
Make-Required Affidavit
Mail or Deliver Report to:
Conservation Division
State Corporation Commission
800 Bitting Building
Wichita, Kansas

Pawnee County. Sec. 17 Twp 21s Rge. (E) 16 (W)

Location as "NE/CNW%SW%" or footage from lines NE NE NE
Lease Owner Sunray Oil Corporation
Lease Name De Roo Well No. 1
Office Address 802 Petroleum Bldg., Wichita
Character of Well (completed as Oil, Gas or Dry Hole) Dry Hole
Date well completed 10 June 19 53
Application for plugging filed 10 June 19 53
Application for plugging approved 10 June 19 53
Plugging commenced 10 June 19 53
Plugging completed 10 June 19 53
Reason for abandonment of well or producing formation Dry Hole

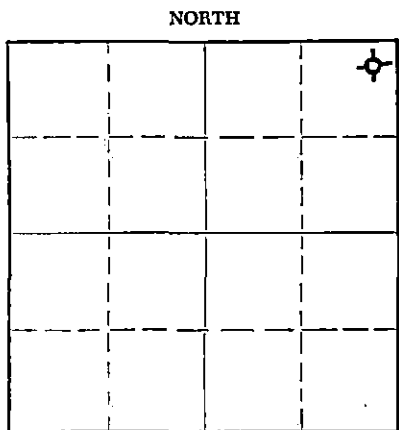

Locate well correctly on above Section Plat

If a producing well is abandoned, date of last production None 19
Was permission obtained from the Conservation Division or its agents before plugging was commenced? Yes

Name of Conservation Agent who supervised plugging of this well M.A. Rives
Producing formation None Depth to top Bottom Total Depth of Well 3876 Feet
Show depth and thickness of all water, oil and gas formations.

OIL, GAS OR WATER RECORDS

CASING RECORD

FORMATION	CONTENT	FROM	TO	SIZE	PUT IN	PULLED OUT
Surface	Fresh Water	0	110	8 5/8	1004	None

Describe in detail the manner in which the well was plugged, indicating where the mud fluid was placed and the method or methods used in introducing it into the hole. If cement or other plugs were used, state the character of same and depth placed, from feet to feet for each plug set.

Jet Pits - Heavy Rotary Mud & Cuttings 3876 to 270 ft.

Halliburton Plug 270 ft.
One-half sack cotton seed hulls and twenty sacks cement 270 to 216.

Rotary Mud & Cuttings 216 - 40 ft.

Halliburton Plug 40 ft.
One-half sack cotton seed hulls and ten sacks cement 40 - 13 ft.

(All measurements 5 feet above Ground Level).

Halliburton Pump Truck & Plugs used in plugging.

(If additional description is necessary, use BACK of this sheet)

Name of Plugging Contractor Stickle Drilling Co.
Address 507 Bitting Bldg., Wichita

STATE OF Kansas, COUNTY OF Sedgwick, ss.
R.B. Parriott (employee of owner) or (~~owner or operator~~) of the above-described well, being first duly sworn on oath, says: That I have knowledge of the facts, statements, and matters herein contained and the log of the above-described well as filed and that the same are true and correct. So help me God.


(Signature) R.B. Parriott

507 Bitting Bldg., Wichita
(Address)

SUBSCRIBED AND SWORN TO before me this 6-16-53 16th day of June, 19 53

Gladys Ternary
Notary Public.

My commission expires August 22, 1953

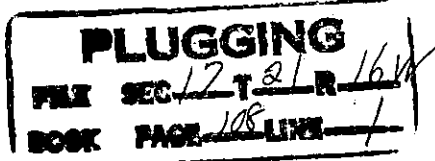

Sunray & Stickle
Tulsa, Oklahoma

Tulsa, Oklahoma
June 17, 1953

CONTRACTOR: Stickle Drilling Company
Drilling Commenced: May 28, 1953
Drilling Completed: June 10, 1953

DeRoo #1 NE-NE-NE-
Section 17-21S-16W,
Pawnee County, Kansas.

DRILLERS LOG

Clay & Rock	0-184
Shale & Shells	184-425
Red Bed	425-995
Anhydrite	995-1025
Shale & Shells	1025-1720
Shale & Lime	1720-2105
Lime & Shale	2105-2480
Shale & Shells	2480-2770
Shale & Lime	2770-2900
Lime	2900-2965
Shale & Lime	2965-3200
Lime	3200-3285
Lime & Shale	3285-3340
Lime	3340-3378
Shale & Lime	3378-3480
Lime	3480-3715
Cherty Lime	3715-3760
Lime & Chert	3760-3795
Conglomerate	3795-3800
Simpson	3800-3820
Dolomite	3820-3876 TD

I, Frank E. Stickle, hereby certify the above to be a true and complete drillers log of Sunray and Stickle, DeRoo #1 NE-NE-NE-Section 17-21S-16W, Pawnee County, Kansas.

Frank E. Stickle
Frank E. Stickle

Lillian T. Bonham
Notary Public

February 13, 1956
My Commission Expires

PLUGGING
FILE SEC 17 T 21 R 16W
BOOK PAGE 108 LINE 1

RECEIVED
STATE CORPORATION COMMISSION
JUN 17 1953
CONFIRMATION DIVISION
Wichita, Kansas