


STATE OF KANSAS
STATE CORPORATION COMMISSION

WELL PLUGGING RECORD

Give All Information Completely
Make Required Affidavit
Mail or Deliver Report to:
Conservation Division
State Corporation Commission
800 Bitting Building
Wichita, Kansas

NORTH

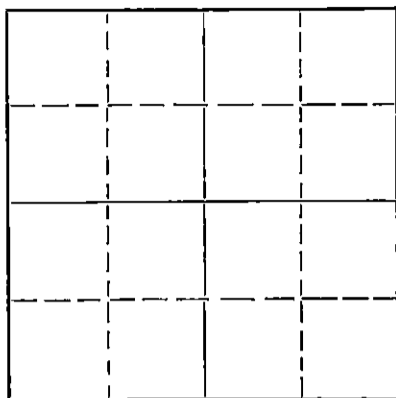

Locate well correctly on above
Section Plat

Pawnee County County. Sec. 23 Twp. 21 Rge. 16 (E) (W)
Location as "NE/CNW%SW%" or footage from lines NE SW SW
Lease Owner Westpan Hydrocarbon Company
Lease Name FOX Well No. 2
Office Address 118 Polk Street - Amarillo, Texas
Character of Well (completed as Oil, Gas or Dry Hole) Dry Hole
Date well completed December 23, 19 53
Application for plugging filed December 23, 19 53
Application for plugging approved December 23, 19 53
Plugging commenced December 23, 19 53
Plugging completed December 23, 19 53

Reason for abandonment of well or producing formation Dry Hole

If a producing well is abandoned, date of last production 19
Was permission obtained from the Conservation Division or its agents before plugging was commenced? Yes.

Name of Conservation Agent who supervised plugging of this well Mr. W. H. Horner
Producing formation _____ Depth to top _____ Bottom _____ Total Depth of Well 3905 Feet
Show depth and thickness of all water, oil and gas formations.

OIL, GAS OR WATER RECORDS

CASING RECORD

FORMATION	CONTENT	FROM	TO	SIZE	PUT IN	PULLED OUT
				8 5/8"	984'	None

Describe in detail the manner in which the well was plugged, indicating where the mud fluid was placed and the method or methods used in introducing it into the hole. If cement or other plugs were used, state the character of same and depth placed, from _____ feet to _____ feet for each plug set.

Muded up to 280'. 1/3 sack of hulls ahead
of wooden plug. Plug pushed to 300'. Dis-
placed 20 sacks cement through drill pipe.

Muded to 35'. 1/3 sack hulls ahead of 2nd
wooden plug. Filled hole with 10 sacks of
cement to top of surface pipe.

12-30-53

(If additional description is necessary, use BACK of this sheet)

Name of Plugging Contractor Garvey Drilling Company
Address R. R. #2, Great Bend, Kansas

STATE OF KANSAS, COUNTY OF SEDGWICK, ss. W. W. Fisher agent of owner
(employee of owner) or (owner or operator) of the above-described
well, being first duly sworn on oath, says: That I have knowledge of the facts, statements, and matters herein contained and the log of the
above-described well as filed and that the same are true and correct. So help me God.


(Signature) W W Fisher
305 East Third Street, Wichita, Kansas
(Address)

SUBSCRIBED AND SWORN TO before me this 26th day of December, 19 53

My commission expires October 13, 1954

Notary Public.

24-7366-5 3-53-20M

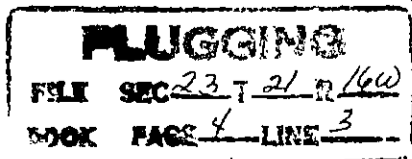

DRILLER'S LOG FOX NO. 2

Westpan Hydrocarbon Company, Operator

Section 23, Twp. 21S, Rge. 16W

Garvey Drilling Company, Contractor

Location: NE SW SW

Drilling Commenced: December 10, 1953

County: Pawnee County, Kansas

Drilling Completed: December 23, 1953

Production: D & A

Casing Record: 8 5/8" @ 98lb w/500 sax

Figures below indicate bottom of formation:

135	Sod & Sand
290	Shale & Shells
416	Shale
520	Sand
555	Shale & Shells
580	Shale & Sand
974	Red Bed
1000	Anhydrite
1725	Shale & Shells
2300	Lime & Shale
2400	Lime
2735	Lime & Shale
2880	Shale & Shells
3062	Lime & Shale
3165	Lime, Shells & Shale
3386	Lime
3481	Lime & Shale
3751	Lime
3808	Cherty Lime
3844	Chert & Shale
3890	Shale
3905	Shale & Lime
3905	R.T.D.

I hereby certify that this is a true and correct log of the above mentioned well.

GARVEY DRILLING COMPANY

By W. W. Fisher

STATE OF KANSAS)
) SS:
COUNTY OF SEDGWICK)

Subscribed to and sworn to before me, a Notary Public, in said County and State, this 26th day of December, 1953.

Charlotte Sherson
Notary Public

My omission expires: October 13, 1954.

PLUGGING
FILE SEC 23 T 21 R 16W
BOOK PAGE 4 LINE 3