


REC'D AUG 19 1963

STATE OF KANSAS
STATE CORPORATION COMMISSION
Give All Information Completely
Make Required Affidavit
Mail or Deliver Report to:
Conservation Division
State Corporation Commission
211 No. Broadway
Wichita, Kansas

WELL PLUGGING RECORD

Pawnee County. Sec. 23 Twp. 21S Rge. 16W (~~X~~) (W)
Location as "NE/CNW/SW" or footage from lines NE NW SW
Lease Owner Rock Island Oil & Refining Co., Inc.
Lease Name Fox Well No. 1
Office Address 321 W. Douglas, Wichita, Kansas
Character of Well (completed as Oil, Gas or Dry Hole) Dry Hole
Date well completed August 4th 1963
Application for plugging filed August ~~XXXX~~ 4th. 1963
Application for plugging approved August 4th. 1963
Plugging commenced 11:30 AM, 8-4-63 1963
Plugging completed 2:30 PM, 8-4- 1963
Reason for abandonment of well or producing formation No production

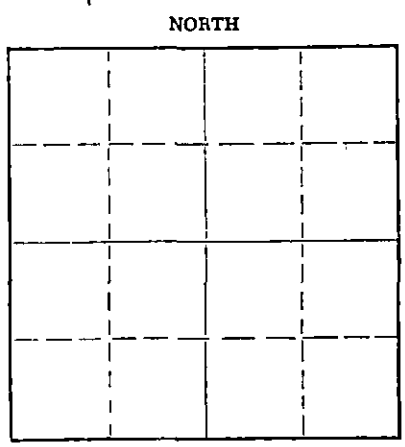

Locate well correctly on above Section Plat

If a producing well is abandoned, date of last production _____ 19____
Was permission obtained from the Conservation Division or its agents before plugging was commenced? Yes

Name of Conservation Agent who supervised plugging of this well Eldon Petty
Producing formation _____ Depth to top _____ Bottom _____ Total Depth of Well 3952' Feet
Show depth and thickness of all water, oil and gas formations.

OIL, GAS OR WATER RECORDS

CASING RECORD

FORMATION	CONTENT	FROM	TO	SIZE	PUT IN	PULLED OUT
				8 5/8"	991'	

Describe in detail the manner in which the well was plugged, indicating where the mud fluid was placed and the method or methods used in introducing it into the hole. If cement or other plugs were used, state the character of same and depth placed, from _____ feet to _____ feet for each plug set.

Displaced heavy mud to 400', pushed wooden plug to 400', displaced 20 sx cement from 400' to 340' through drill pipe, displaced heavy mud to 180', pushed wooden plug 180', displaced 20 sx cement from 180' to 120' through drill pipe, displaced heavy mud to 35', pushed wooden plug to 35', displaced 10 sx cement to top through drill pipe. Job complete 2:30 PM, 8-4-63.

RECEIVED
STATE CORPORATION COMMISSION

AUG 20 1963

CONSERVATION DIVISION
Wichita, Kansas

8-20-63

(If additional description is necessary, use BACK of this sheet)
Name of Plugging Contractor Garvey Drilling Company
Address RR #2 Great Bend, Kansas

STATE OF Kansas, COUNTY OF Barton, ss.
Sam N. Stephens (employee of owner) or (~~owner~~) of the above-described well, being first duly sworn on oath, says: That I have knowledge of the facts, statements, and matters herein contained and the log of the above-described well as filed and that the same are true and correct. So help me God.

(Signature) Sam N. Stephens
RR #2 Great Bend, Kansas
(Address)

SUBSCRIBED AND SWORN TO before me this 16th day of August, 1963

My commission expires April 14th, 1967
Arthur J. Wile Notary Public.

WELL LOG

15.145.01030-0000

COMPANY **Rock Island Oil & Refining Co., Inc.**

SEC. 23 T. 21S. 16W

FARM **Fox**

NO. 1

LOC. NE NW SW


TOTAL DEPTH **3952'**

COUNTY **Pawnee**

COMM. **7-25-63**

COMP. **8-4-63**

CONTRACTOR **Garvey Drilling Company**

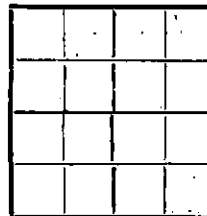

CASING **8 5/8" @ 991' w/300 SX**

ELEVATION

PRODUCTION **D & A**

FIGURES INDICATE BOTTOM OF FORMATIONS

- 205' Sand
- 420' Shale and Red Bed
- 510' Sand
- 720' Sandy Red Sand
- 978' Red Bed and Shale
- 1040' Anhydrite
- 1190' Red Bed
- 1730' Shale
- 2064' Lime and Shale
- 2305' Lime
- 2338' Lime and Shale
- 2510' Shale and Lime
- 3215' Lime and Shale
- 3390' Lime
- 3501' Shale and Lime
- 3515' Lansing Lime
- 3800' Lime
- 3825' Shale, Lime, and Chert
- 3895' Chert and Lime
- 3945' Shale and Chert
- 3952' Lime
- 3952' RTD

RECEIVED
STATE CORPORATION COMMISSION

AUG 20 1963

CONSERVATION DIVISION
Wichita, Kansas

State of Kansas }
County of Barton } SS

I, Sam N. Stephens of Garvey Drilling Company
upon oath state the above and foregoing is a true and correct copy of the log of the Fox #1 well.

Sam N. Stephens

Subscribed and sworn to before me this 7th day of August 19 63

My Commission Expires: April 14th, 1967

Arthur J. Wiles
NOTARY PUBLIC