

STATE OF KANSAS  
STATE CORPORATION COMMISSION

WELL PLUGGING RECORD

Give All Information Completely  
Make Required Affidavit  
Mail or Deliver Report to:  
Conservation Division  
State Corporation Commission  
211 N.W. Broadway  
Wichita, Kansas

Pawnee County, Sec. 23 Twp. 21 Rge. 16 (E) (W)

Location as "NE/CNW/SW" or footage from lines SW SW SW

Lease Owner Forbes Casing Pulling, Inc.

Lease Name M. M. Fox Well No. 1

Office Address P. O. Box 221 Great Bend, Kansas

Character of Well (completed as Oil, Gas or Dry Hole) \_\_\_\_\_

Date well completed \_\_\_\_\_ 19\_\_\_\_

Application for plugging filed 8-22-63 19\_\_\_\_

Application for plugging approved 8-23-63 19\_\_\_\_


Plugging commenced 8-23-63 19\_\_\_\_

Plugging completed 11-19-63 19\_\_\_\_

Reason for abandonment of well or producing formation Dry

If a producing well is abandoned, date of last production \_\_\_\_\_ 19\_\_\_\_

Was permission obtained from the Conservation Division or its agents before plugging was commenced? Yes

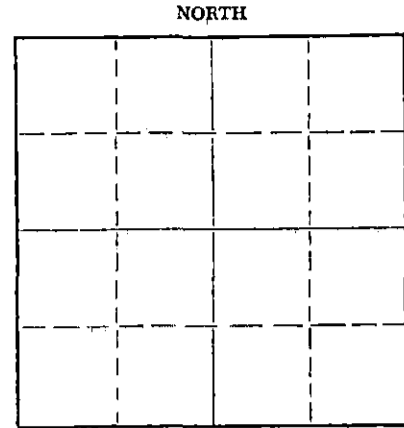

Locate well correctly on above Section Plat

Name of Conservation Agent who supervised plugging of this well Eldon Petty

Producing formation \_\_\_\_\_ Depth to top \_\_\_\_\_ Bottom \_\_\_\_\_ Total Depth of Well 3859 Feet

Show depth and thickness of all water, oil and gas formations.

OIL, GAS OR WATER RECORDS

CASING RECORD

FORMATION	CONTENT	FROM	TO	SIZE	PUT IN	PULLED OUT
				8 5/8	987	None
				5 1/2	None	2876

Describe in detail the manner in which the well was plugged, indicating where the mud fluid was placed and the method or methods used in introducing it into the hole. If cement or other plugs were used, state the character of same and depth placed, from \_\_\_\_\_ feet to \_\_\_\_\_ feet for each plug set.

Setting up unit.

Measured T. D. 3859'. Sanded to 3840'. Dumped 4 sacks of cement with bailer. Cleaned out cellar. Rigged up jacks. Shot pipe at 3000'.

Cutting off head. Put on control head - had 21 1/2" tension. Shot pipe at 2846' - had 22 1/2" tension. Working pipe.

Circulating. Spotted 65 bbl. of oil.

Cleaning mud and water out of cellar. Dumped sand and 6 sacks of cement in bottom of cellar.

Pipe started at 2846'.

Pulled pipe.

Put oil in reserve tank. Took off control head. Put on 8 5/8" plug container. Finished pulling pipe. Squeezed 8 5/8" casing with 40 sacks of mud and 100 sacks of cement.

(If additional description is necessary, use BACK of this sheet)

Name of Plugging Contractor Forbes Casing Pulling, Inc.

Address P. O. Box 221 Great Bend, Kansas

STATE OF Kansas, COUNTY OF Barton, ss. J. O. Forbes

(employee of owner) or (owner or operator) of the above-described well, being first duly sworn on oath, says: That I have knowledge of the facts, statements, and matters herein contained and the log of the above-described well as filed and that the same are true and correct. So help me God.

(Signature) J. O. Forbes  
P. O. Box 221 Great Bend, Kansas  
(Address)

SUBSCRIBED AND SWORN TO before me this 22 day of November, 1963

My commission expires May 27, 1964

[Signature]  
Notary Public.

RECEIVED  
STATE CORPORATION COMMISSION  
NOV 26 1963  
WICHITA, KANSAS  
CONSERVATION DIVISION

11-26-63

D R I L L E R ' S   L O G

COMPANY: WESTPAX HYDROCARBON COMPANY  
 CONTRACTOR: HILTON DRILLING COMPANY, INC.  
 FARM NAME: FOX NO. 1  
 COMMENCED: 10-30-53  
 COMPLETED: 11-13-53

LOCATION: SW SW SW 23-21-16  
 Pawnee County, Kansas  
 ELEVATION: 1978 DF

Casing Used: 8 5/8" @ 987' w/ 450 sx.  
 5 1/2" @ 3856' w/ 125 sx.

Sand	80
Shale and Sand	110
Shale, Sand and shells	340
Sand	350
Shale and Shells	395
Red Bed	425
Sand	485
Red Bed, Shale and Shells	977
Anhydrite	1005
Shale and Shells	1140
Shale, Shells, and Salt	1425
Shale and Lime	1920
Lime	2135
Shale and Lime	2170
Lime	2340
Lime and Shale	2893
Lime	3359
Lime and Shale	3472
Lime	3723
Lime and Shale	3749
Chert, Lime, and Shale	3785
Shale and Lime	3855
Total Depth	3859

RECEIVED  
 STATE CORPORATION COMMISSION

AUG 23 1963

CONSERVATION DIVISION  
 Wichita, Kansas

STATE OF KANSAS    )  
                           ) SS  
 COUNTY OF BARTON   )

*FOX #1  
 General*

I, the undersigned, being duly sworn on oath, state that the above statement and log are true and a correct record and log of the well drilled at the location above described.

HILTON DRILLING COMPANY, INC.

*Henry Peacock*  
 Henry Peacock, Secretary

Subscribed and sworn to before me this 16th day of November, 1953.

My commission expires 4-4-56.

*Margaret Whitman*  
 Notary Public