

WELL PLUGGING RECORD

Give All Information Completely  
Make Required Affidavit  
Mail or Deliver Report to:  
Conservation Division  
State Corporation Commission  
800 Bitting Building  
Wichita, Kansas

Pawnee

County. Sec. 23 Twp. 21 Rge. 16 ~~(E)~~ (W)

Location as "NE/CNW&SWK" or footage from lines NE SE NE

Lease Owner Welch & Olsson Drilling Co. Inc.

Lease Name Schmidt Well No. 1

Office Address 203 Rule Bldg. Wichita, Ks.

Character of Well (completed as Oil, Gas or Dry Hole) D&A

Date well completed 1-18 19 55

Application for plugging filed 1-18 19 55

Application for plugging approved 1-18 19 55


Plugging commenced 1-18 19 55

Plugging completed 1-18 19 55

Reason for abandonment of well or producing formation D & A

If a producing well is abandoned, date of last production None 19     

Was permission obtained from the Conservation Division or its agents before plugging was commenced? Yes

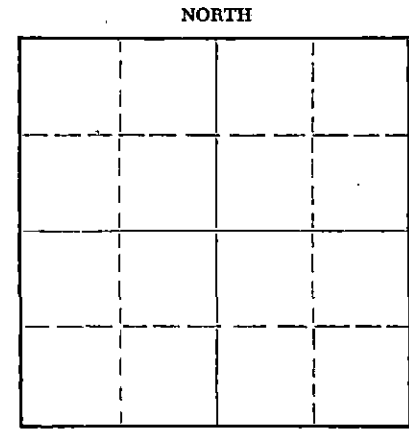

Locate well correctly on above Section Plat

Name of Conservation Agent who supervised plugging of this well M. A. Rives, Box 8, Pratt, Kansas

Producing formation      Depth to top      Bottom      Total Depth of Well 3855' Feet

Show depth and thickness of all water, oil and gas formations.

OIL, GAS OR WATER RECORDS

CASING RECORD

FORMATION	CONTENT	FROM	TO	SIZE	PUT IN	PULLED OUT
				8 5/8"	994	None

Describe in detail the manner in which the well was plugged, indicating where the mud fluid was placed and the method or methods used in introducing it into the hole. If cement or other plugs were used, state the character of same and depth placed, from      feet to      feet for each plug set.

First Plug set at 300' with 20 sacks of cement;

Second plug set at 35' with 10 sacks of cement;

Hole filled to surface; surface pipe cut off and capped.

Name of Plugging Contractor Welch & Olsson Drilling Co. Inc. (If additional description is necessary, use BACK of this sheet)  
Address 203 Rule Bldg. Wichita, Ks.

STATE OF Kansas Sedgwick COUNTY OF Sedgwick, ss.  
R. E. Welch

(employee of owner) or (owner or operator) of the above-described well, being first duly sworn on oath, says: That I have knowledge of the facts, statements, and matters herein contained and the log of the above-described well as filed and that the same are true and correct. So help me God.

(Signature) [Signature]  
203 Rule Bldg. Wichita, Ks. (Address)

SUBSCRIBED AND SWORN TO before me this 21st day of January, 19 55

My commission expires June 12, 1955

[Signature] Notary Public.

PLUGGING  
FILE SEC 23T-21R-6W  
BOOK PAGE 92 LINE 31

FEB 2-4-55  
CONSERVATION DIVISION  
WICHITA, KANSAS

WELL LOG.

WELCH & OLSSON DRILLING COMPANY, INC.  
 CONTRACTOR: Welch & Olsson Drlg. Co. Inc.  
 SCHMIDT  
 NE SE NE 23-21-16W.  
 Pawnee County, Kansas.

ELEVATION: 1978 R.B.  
 Comm. Drlg: 1-7-55  
 Comp. Drlg: 1-18-55  
 Production: D & A

Casing Record:  
 994' of 8 5/8" with 400 sacks.

(Figures indicate bottom of Formations.)

<u>FORMATIONS:</u>	<u>DEPTHS</u>	<u>FORMATION TOPS.</u>
Sand:	70	Anhydrite (driller top) 968 (Plus 1010)
Shale with Sand stks:	385	Heebner.....3361 (-1383)
Sand:	505	Toronto.....3381 (-1403)
Red Bed & Shale:	968	Brown Lime.....3460 (-1482)
Anhydrite:	984	Lansing-Kansas City...3472 (-1494)
Shale & Shells:	1775	Base Kansas City.....3680 (-1702)
Shale w/Lime Strs:	1835	Conglomerate.....3720 (-1742)
Shale & Lime:	2130	Viola.....3733 (-1755)
Lime:	2180	Simpson.....3791 (-1813)
Lime & Shale:	2375	Arbuckle.....3849 (-1871)
Shale & Shells:	2415	
Shale & Lime:	2540	
Shale & Shells:	3050	
Shale & Lime:	3190	
Lime:	3361	
Shale:	3366	
Lime:	3390	
Lime & Shale:	3460	
Lime:	3750	
Sand and Shale:	3849	
Chert and Dolomite:	3855 T.D.	

STATE OF KANSAS, )  
 ) SS:  
 SEDGWICK COUNTY, )

I hereby certify that the above is a true and correct copy of Drillers Log of well drilled in the NE SE NW of Section 23, Township 21, Range 16W, Pawnee County, Kansas.

WELCH & OLSSON DRILLING COMPANY, INC.  
 BY R. E. Welch  
 R. E. WELCH

Subscribed and sworn to before me this 21st day of January, 1955.

Seeth Stuber  
 Notary Public.

My commission expires:  
 June 12, 1955

**PLUGGING**  
 FILE SEC 23-21-16W  
 PAGE 92 LINE 31

RECEIVED  
 STATE COURT  
 FILED  
 CONSERVATION  
 WELL