


STATE OF KANSAS
STATE CORPORATION COMMISSION

WELL PLUGGING RECORD

Give All Information Completely.
Make Required Affidavit
Mail or Deliver Report to
Conservation Division
State Corporation Comm.
245 North Water
Wichita, KS 67202

Barton County. Sec. 9 Twp. 16 Rge. 12 x E/W
Location as "NE/CNW $\frac{1}{4}$ /SW $\frac{1}{4}$ " or footage from lines _____

Lease Owner NW NE NE
Four Way Operating Inc.
Lease Name Reck Well No. 2
Office Address Box 698, Great Bend, Kansas 67530
Character of Well (Completed as Oil, Gas or Dry Hole) _____

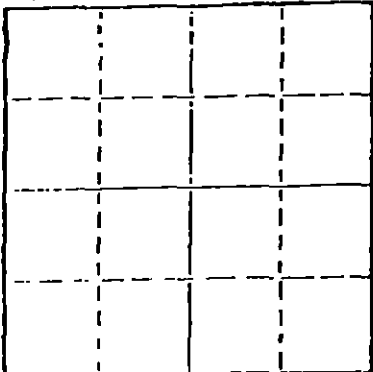

Locate well correctly on above
Section Plat

dry hole
Date Well completed Jan. 8 1979
Application for plugging filed Jan. 8 1979
Application for plugging approved Jan. 8 1979
Plugging commenced Jan. 8 1979
Plugging completed Jan. 8 1979
Reason for abandonment of well or producing formation _____
dry hole

If a producing well is abandoned, date of last production _____
19 _____

Was permission obtained from the Conservation Division or
its agents before plugging was commenced? yes

Name of Conservation Agent who supervised plugging of this well Duane L. Rankin
Producing formation _____ Depth to top _____ Bottom _____ Total Depth of Well 3370
Show depth and thickness of all water, oil and gas formations.

OIL, GAS OR WATER RECORDS

CASING RECORD

FORMATION	CONTENT	FROM	TO	SIZE	PUT IN	PULLED OUT
				8 5/8	218'	

Describe in detail the manner in which the well was plugged, indicating where the mud fluid
was placed and the method or methods used in introducing it into the hold. If cement or other
plugs were used, state the character of same and depth placed, from _____ feet to
_____ feet for each plug set.

1st plug 420 w/50 sx.
2nd plug 210 w/25 sx.
3rd plug 40 w/10 sx.
2 sx in rathole

RECEIVED
STATE CORPORATION COMMISSION
JAN 2 1979
CONSERVATION DIVISION
Wichita Kansas

(If additional description is necessary, use BACK of this sheet)
Name of Plugging Contractor Woodman & Iannitti Drilling Co.

STATE OF KANSAS COUNTY OF SEDGWICK, ss.
K. T. Woodman (employee of owner) or (owner or operator)

of the above-described well, being first duly sworn on oath, says: That I have knowledge of
the facts, statements, and matters herein contained and the log of the above-described well
as filed and that the same are true and correct. So help me God.


(Signature) K. T. Woodman

1008 Douglas Bldg. 104 So. Broadway
(Address)

SUBSCRIBED AND SWORN TO before me this 10th day of January, 19 79

My commission expires Feb. 11, 1980

Justina Chamberlain
Justina Chamberlain Notary Public.

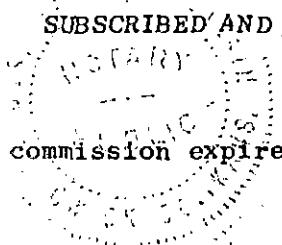

K. T. WOODMAN
RES. PHONE 733-0418
OFF. PHONE 265-7650
WICHITA, KANSAS

15.009-21547-00-00

D. J. IANNITTI
PHONE 792-2921
GREAT BEND, KANSAS

WOODMAN & IANNITTI DRILLING COMPANY
Rotary Drilling Contractors

1008 DOUGLAS BUILDING
104 S. BROADWAY
WICHITA, KANSAS 67202

January 10, 1979

Company;	Four Way Operating Inc.
Farm;	#2 Reck
Location;	NW NE NE
Section;	9-16-12W
County;	Barton
Contractor;	Woodman & Iannitti Drilling Co.
Comm;	January 2, 1979
Compl;	January 8, 1979
Total Depth;	3370'
Casing;	8 5/8 @ 218' w/150 sx.
Production;	D & A

Figures Indicate Bottom Of Formations:

45	Surface soil & post rock
102	Shale
202	Shale
308	Shale
310	Hard sand
790	Shale & red bed
794	Shale & red bed
820	Anhy
1470	Shale
1945	Shale & lime
2175	Shale & Lime
2730	Shale & lime
2870	Lime
3085	Lime & shale
3160	Lime
3250	Lime & shale
3335	Lime & shale
3370	Cong.

RECEIVED
STATE CORPORATION COMMISSION
JAN 12 1979
CONSERVATION DIVISION
Wichita, Kansas

I certify the above to be a true and correct copy of the driller's log to the best of my knowledge and belief.

Woodman & Iannitti Drilling Co.

K. T. Woodman

K. T. Woodman