

STATE OF KANSAS
STATE CORPORATION COMMISSION

WELL PLUGGING RECORD

Give All Information Completely
Make Required Affidavit
Mail or Deliver Report to:
Conservation Division
State Corporation Commission
800 Bittling Building
Wichita, Kansas

OR
FORMATION PLUGGING RECORD

Strike out upper line
when reporting plugging
off formations.

Barton County. Sec. 9 Twp. 16 Rge. 12 (W)

Location as "NE 1/4 NW 1/4 SW 1/4" or footage from lines SW NE SW

Lease Owner Sunray Oil Corporation

Lease Name Turgeon Well No. 4

Office Address Box 195, Great Bend, Kansas

Character of Well (completed as Oil, Gas or Dry Hole) Dry Hole

Date well completed

Application for plugging filed 11-12 19 48

Application for plugging approved 11-13 19 48


Plugging commenced 11-14 19 48

Plugging completed 11-15 19 48

Reason for abandonment of well or producing formation Dry Hole

If a producing well is abandoned, date of last production 19

Was permission obtained from the Conservation Division or its agents before plugging was commenced? Yes

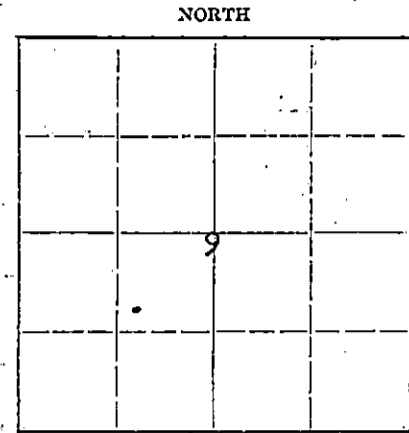

Locate well correctly on above
Section Plat

Name of Conservation Agent who supervised plugging of this well

Producing formation Depth to top Bottom Total Depth of Well 3383 Feet

Show depth and thickness of all water, oil and gas formations.

OIL, GAS OR WATER RECORDS

CASING RECORD

Formation	Content	From	To	Size	Put In	Pulled Out
Lansing	Water	3084'		8-5/8"	821'	0
Reagan	Water	3379'	3383'	5-1/2"	3379'	2021.7'

Describe in detail the manner in which the well was plugged, indicating where the mud fluid was placed and the method or methods used in introducing it into the hold. If cement or other plugs were used, state the character of same and depth placed, from feet to feet for each plug set.

Plugged back w/mud & crushed rock to 2880'
Filled w/mud to 815'
Dumped 5 sx cement
Filled w/mud to 250'
Dumped 15 sx cement
Filled w/mud to bottom of cellar
Capped w/5 sx cement

11-26-48

RECEIVED
NOV 26 1948
STATE CORPORATION COMMISSION
KANSAS

(If additional description is necessary, use BACK of this sheet)

Correspondence regarding this well should be addressed to Sunray Oil Corporation

Address Box 195, Great Bend, Kansas

STATE OF KANSAS, COUNTY OF BARTON, ss.

G. D. Strother, (employee of owner) of the above-described well, being first duly sworn on oath, says: That I have knowledge of the facts, statements, and matters herein contained and the log of the above-described well as filed and that the same are true and correct. So help me God.


(Signature) G. D. Strother Engineer

Box 195, Great Bend, Kansas (Address)

SUBSCRIBED AND SWORN TO before me this 24 day of November, 19 48.

Notary Public

My commission expires April 19, 1952.

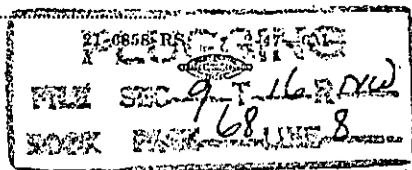

15-009-06771-00-00

Turgeon, No. 4 Well

Drilled for: Sunray Oil Corporation

Sec. 9-16-12W, Barton County, Kansas

Drilled by: Mouser Drilling Company

Drilling Commenced: October 8, 1948

Drilling Completed: October 24, 1948

Casing Record

8 5/8" 821' 32# 8 v thd Casing
5 1/2" 3379' O.D. 8 rd thd Casing

<u>FORMATION</u>	<u>DEPTH</u>	<u>FORMATION</u>	<u>DEPTH</u>
Cellar	5		
Surface clay and rock	60		
Sand and rock	80		
Shale and shells	155		
Sand and shale	165		
Shale and shells	375		
Sand - sharp	405		
Iron	410		
Shale and shells	540		
Red bed	809		
Anhydrite	835		
Shale and shells	1165		
Salt	1400		
Shale and shells	1495		
Lime and shale	1870		
Sand and shale	1920		
Lime and shale	2300		
Shale and shells	2350		
Lime and shale	2619		
Shale	2659		
Lime and shale	2710		
Lime	3012		
Lime and sand and shale	3072		
Lime	3341		
Conglomerate	3379		
Quartzite	3383		
		Top Topeka	2699'
		Top K.C.	3084'
Total Depth	3383'		

RECEIVED
NOV 28 1948
STATE COMMISSION
KANSAS

STATE OF KANSAS
SS:
COUNTY OF SEDGWICK

I, the undersigned, being duly sworn on oath, state that the above and within statement is a true and correct record and log of the well drilled on the above described location to the best of my knowledge and belief.

L. Mouser

Subscribed and sworn to before me this 29th day of October 1948.

My Commission Expires:

March 18 1950 PLUGGING Frances S. Webber

FILE SEC-9-T-16-R-170
BOOK PAGE 68 LINE 8