


STATE OF KANSAS  
STATE CORPORATION COMMISSION

Give All Information Completely  
Make Required Affidavit  
Mail or Deliver Here to:  
Conservation Division  
State Corporation Commission  
800 Bittling Building  
Wichita, Kansas

OR  
FORMATION PLUGGING RECORD

Strike out upper line  
when reporting plugging  
of formations.

Pawnee County, Sec 13 Twp 21S Rge ~~16~~ 16 (W)  
Location as "NE $\frac{1}{4}$ NW $\frac{1}{4}$ SW $\frac{1}{4}$ " or footage from lines SE SE NW  
Lease Owner Sohio Petroleum Company  
Lease Name Henneigh Well No. 1  
Office Address Box 671, Russell, Kansas  
Character of Well (completed as Oil, Gas or Dry Hole) Dry Hole  
Date well completed April 27 19 48  
Application for plugging filed April 27 19 48  
Application for plugging approved By telephone April 27 19 48  
Plugging commenced April 27 19 48  
Plugging completed April 27 19 48  
Reason for abandonment of well or producing formation Dry Hole

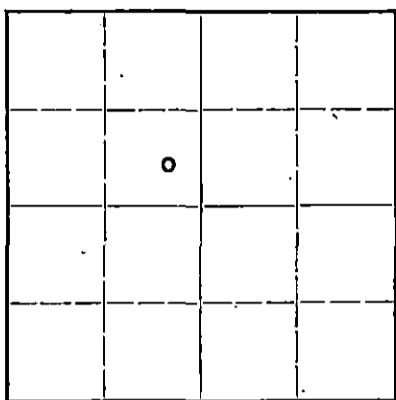

Locate well correctly on above  
Section Plat

If a producing well is abandoned, date of last production 19  
Was permission obtained from the Conservation Division or its agents before plugging was commenced? Yes  
Name of Conservation Agent who supervised plugging of this well Mr. C. D. Stough  
Producing formation None Depth to top Bottom Total Depth of Well 3880 Feet  
Show depth and thickness of all water, oil and gas formations.

OIL, GAS OR WATER RECORDS

CASING RECORD

Formation	Content	From	To	Size	Put In	Pulled Out
No commercial oil nor gas shows from top to bottom				8 5/8"	965'	None

Describe in detail the manner in which the well was plugged, indicating where the mud fluid was placed and the method or methods used in introducing it into the hold. If cement or other plugs were used, state the character of same and depth placed, from feet to feet for each plug set.

3880' - 2045' - Heavy Mud  
2045' - 2010' - Cement - 40 Sacks  
2010' - 202' - Heavy Mud  
202' - 198' - Wood Bridge  
198' - 100' - Heavy Mud and Cotton Seed Hulls  
100' - 2' - Cement - 35 Sacks  
2' - 0 - Dirt

5-348

MAY 2 1948

(If additional description is necessary, use BACK of this sheet)

Correspondence regarding this well should be addressed to Sohio Petroleum Company  
Address Russell, Kansas

STATE OF Kansas, COUNTY OF Russell, ss.


Doyle Fair (employee of owner) or (owner or operator) of the above-described well, being first duly sworn on oath, says: That I have knowledge of the facts, statements, and matters herein contained and the log of the above-described well as filed and that the same are true and correct. So help me God.

(Signature) Doyle Fair  
Box 68, Russell, Kansas  
(Address)

SUBSCRIBED AND SWORN to before me this 29th day of April 19 48

My commission expires May 8, 1948.

My commission expires Notary Public.

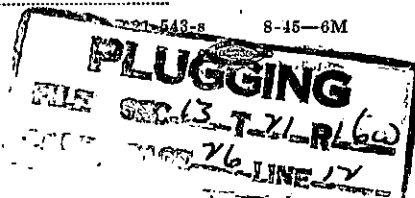

**CONTRACTOR'S VERIFIED LOG**

Operator Sohio Petroleum Company Farm Name Henneigh Well No. 1

Location SE SE NW Section 13-21S-16W

Pool Name Wildcat County Pawnee State Kansas

Commencement Date 4-11-48 Completion Date 4-27-48

**LOG OF WELL**

Depth		Formation	Deviation from Vertical (Degrees)	Remarks
From	To			
0	5	Rig		
5	10	Cellar		
10	175	Sand		
175	391	Shale and Shells		
391	495	Sand	Syfos at	
495	600	Red Bed and Shale	500'	
600	610	Sand		
610	955	Shale and Red Bed		Ran 965' of 8 5/8" casing and cemented with 500 Sacks Sulphate Resistant Cement
955	958	Gyp	1000'	
958	978	Anhydrite		
978	1150	Red Bed	1500'	
1150	1850	Shale and Shells		
1850	2850	Lime and Shale	2000'	
2850	2870	Lime	2500'	
2870	3118	Broken Lime		
3118	3370	Lime		
3370	3445	Shale		
3445	3690	Lime	All OK	Set cement plug from 1990' to 2040' for test
3690	3740	Shale and Lime		
3740	3782	Conglomerate		
3782	3822	Shale and Chert		
3822	3880	Arbuckle Lime		
Dry and Abandoned				

MAY 5 - 1948

**PLUGGING**  
 FILE SEC 13-21-16W  
 BOOK PAGE 26 LINE 17

