

STATE OF KANSAS  
STATE CORPORATION COMMISSION


Give All Information Completely  
Make Required Affidavit  
Mail or Deliver Report to:  
Conservation Division  
State Corporation Commission  
212 No. Market  
Wichita, Kansas

WELL PLUGGING RECORD

Pawnee County, Sec. 13 Twp. 21S Rge. 16W (E) (W)

Location as "NE/CNWXSWX" or footage from lines \_\_\_\_\_  
Lease Owner Messman-Rinehart Oil Company  
Lease Name Haney Well No. 1  
Office Address 1432 Wichita Plaza  
Character of Well (completed as Oil, Gas or Dry Hole) Dry Hole  
Date well completed 11-7 19 69  
Application for plugging filed 11-7 19 69  
Application for plugging approved 11-7 19 69  
Plugging commenced 11-7 19 69  
Plugging completed 11-7 19 69  
Reason for abandonment of well or producing formation Dry Hole

NORTH

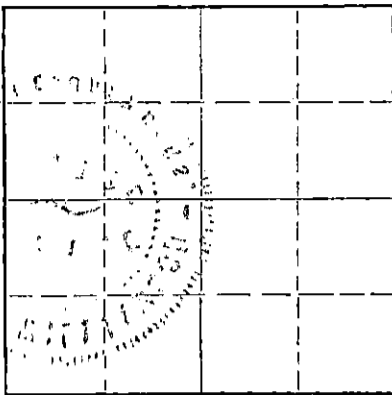

Locate well correctly on above  
Section Plat

If a producing well is abandoned, date of last production \_\_\_\_\_ 19\_\_\_\_  
Was permission obtained from the Conservation Division or its agents before plugging was commenced? Yes

Name of Conservation Agent who supervised plugging of this well Leo F. Massey  
Producing formation \_\_\_\_\_ Depth to top \_\_\_\_\_ Bottom \_\_\_\_\_ Total Depth of Well \_\_\_\_\_ Feet  
Show depth and thickness of all water, oil and gas formations.


OIL, GAS OR WATER RECORDS

CASING RECORD

FORMATION	CONTENT	FROM	TO	SIZE	PUT IN	PULLED OUT

Describe in detail the manner in which the well was plugged, indicating where the mud fluid was placed and the method or methods used in introducing it into the hole. If cement or other plugs were used, state the character of same and depth placed, from \_\_\_\_\_ feet to \_\_\_\_\_ feet for each plug set.

3887 - 300 - Heavy rotary mud  
300 - Plug, 25 sacks cement  
300 - 39 - Heavy rotary mud  
39 - GL - Plug, 10 sacks cement - 2 sacks in rat hole.

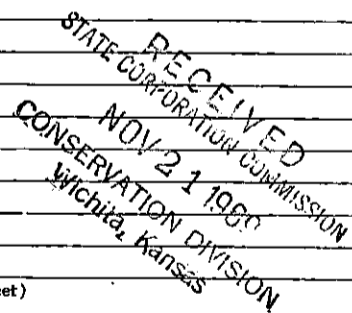

(If additional description is necessary, use BACK of this sheet)  
Name of Plugging Contractor Peel Brothers, Inc.  
Address Box 359, Hoisington, Kansas 67544

STATE OF Kansas, COUNTY OF Barton, ss.  
Peel Brothers, Inc. (employee of owner) of the above-described

well, being first duly sworn on oath, says: That I have knowledge of the facts, statements, and matters herein contained and the log of the above-described well as filed and that the same are true and correct. So help me God. PEEL BROTHERS, INC.

(Signature) Wendell C. Peel  
Wendell C. Peel, President  
(Address)

SUBSCRIBED AND SWORN to before me this 10th day of November, 19 69

My commission expires 6-21-70  
Ethel S. Williamson Notary Public.

