

STATE OF KANSAS
STATE CORPORATION COMMISSION


WELL PLUGGING RECORD

Give All Information Completely
Make Required Affidavit
Mail or Deliver Report to:
Conservation Division
State Corporation Commission
800 Bittling Building
Wichita, Kansas

OR
FORMATION PLUGGING RECORD

Strike out upper line
when reporting plug-
ging of formations.

McPherson County, Sec. 4 Twp. 21 Rge. 2 (E) W (W)
Location as "NE 1/4 NW 1/4 SW 1/4" or footage from lines NEC SW 1/4

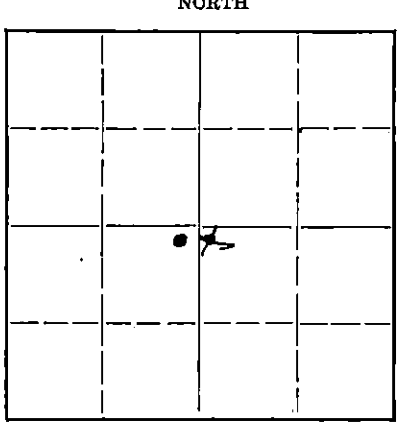

Locate well correctly on above
Section Plat

Lease Owner Branine & Goering
Lease Name Robert Durst Well No. 1
Office Address Newton, Kansas
Character of Well (completed as Oil, Gas or Dry Hole) Dry Hole
Date well completed 12-19-42 19
Application for plugging filed Same day 19
Application for plugging approved Verbal 12-20-42 19
Plugging commenced 12-20-42 19
Plugging completed 12-20-42 19
Reason for abandonment of well or producing formation
Dry Hole
If a producing well is abandoned, date of last production 19
Was permission obtained from the Conservation Division or its agents before plugging was com-
menced? Yes

Name of Conservation Agent who supervised plugging of this well Durkee
Producing formation Depth to top Bottom Total Depth of Well 3625 Feet
Show depth and thickness of all water, oil and gas formations.


OIL, GAS OR WATER RECORDS

CASING RECORD

Formation	Content	From	To	Size	Put In	Pulled Out
				8 5/8	172	None
Filled with mud to 175'. Bridged and plug set at 172' with 10 sacks cement. Filled with mud to 30' and filled with five sacks cement. Surface casing cut three feet under surface and cupped.						

Describe in detail the manner in which the well was plugged, indicating where the mud fluid was placed and the method or methods used in introducing it into the hold. If cement or other plugs were used, state the character of same and depth placed, from feet to feet for each plug set.

FILE SEC 4-21-2W
BOOK PAGE 59 LINE 3

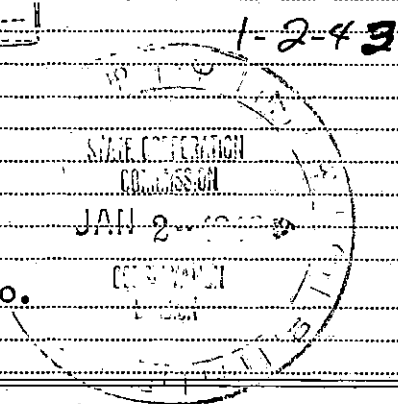

(If additional description is necessary, use BACK of this sheet)
Correspondence regarding this well should be addressed to B & R Drilling Co.
Address Russell, Kansas.

STATE OF Kansas, COUNTY OF Russell, ss.
C.L. Roberts (employee of owner) or (owner or operator) of the above-described well,

being first duly sworn on oath, says: That I have knowledge of the facts, statements, and matters herein contained and the log of the above-described well as filed and that the same are true and correct. So help me God.

(Signature) C.L. Roberts

Russell, Kansas (Address)

SUBSCRIBED AND SWORN to before me this 29 day of December, 19 42

J. Lawrence Poole
Notary Public.

My commission expires July 2, 1945

WELL LOG BUREAU-KANSAS GEOLOGICAL SOCIETY
412 Union National Bk. Bldg., Wichita, Kansas

BEAMINE & GOERING
Robert Durst # 1. 0

SEC. 4 T. 21 R. 2
NE c of SW 1/4
330' NL 330' EL

Total Depth. 3635'

Comm. 11-19-42

Comp. 12-21-42

County, McPherson

Casing:

8 jts. 8 5/8, set at 172'

Cement:

85 sacks

Figures Indicate Bottom of Formation.

surface clay	20	lime and shale	2950
sand and shale	60	shale	2960
shale and shells	165	shale	2990
shale and lime	172	shale and shells	3010
shale and shells	315	chert	3025
shale and lime shells	400	chert and lime	3055
lime & shale anhydrate	505	chert and lime	3070
anhydrite & shale	555	chert and lime	3090
lime sandy	615	chert and lime	3115
lime sandy	740	chert hard	3125
lime and shale	830	chert hard	3140
hard sandy lime	855	cherty lime	3170
lime and shale	920	shale and chert	3185
lime and shale	1015	shale and lime	3205
lime	1040	lime and shale	3220
shale and lime	1070	lime and shale	3255
lime and shale	1135	lime and shale	3290
shale and shells	1210	shale	3305
shale and shells	1375	shale and shells	3355
shale and shells	1450	shale and lime shells	3420
shale & lime shells	1560	shale	3470
broken lime shale	1595	shale and shells	3487
shale and shells	1650	violin lime	3500
lime	1705	lime	3528
lime	1715	sand	3535
shale and shells	1780	shale	3540
lime	1820	? hard	3545
lime and shall	1870	Shale and sand	3565
lime and shale	1935	sand and shale streaks	3595
lime hard	1945	sand and shale	3603
lime	2005	siliceous lime	3610
lime	2070	lime	3625
lime	2115	lime	3635
lime	2120	Total Depth.	
shale & sandy lime	2155		
shale	2200		
shale and lime shells	2295		
lime and shale	2375		
lime	2425		
lime	2471		
lime very soft	2477		
lime	2485		
lime	2515		
lime	2560		
lime	2605		
lime	2650		
lime	2675		
lime and shale	2730		
lime and shale	2785		
lime and shale	2830		
lime and shale	2880		
lime and shale	2920		

BEAMINE & GOERING
FILE 4 21 3W
BOOK PAGE 59 LINE 3






