


STATE OF KANSAS
STATE CORPORATION COMMISSION

WELL PLUGGING RECORD

Give All Information Completely
Make Required Affidavit
Mail or Deliver Report to:
Conservation Division
State Corporation Commission
800 Bitting Building
Wichita, Kansas

Pawnee County, Sec. 35 Twp. 21 Rge. (E) 16 (W)
Location as "NE/CNW/SW" or footage from lines SE SE SW
Lease Owner George Siegrist - Hutchinson, Kansas.
Lease Name HUTCHERSON Well No. 1
Office Address 518 Petroleum Building, Wichita, Kansas.
Character of Well (completed as Oil, Gas or Dry Hole) Dry hole
Date well completed August 8, 1954
Application for plugging filed verbally August 8, 1954
Application for plugging approved verbally August 8, 1954
Plugging commenced August 8, 1954
Plugging completed August 8, 1954
Reason for abandonment of well or producing formation Dry hole

NORTH

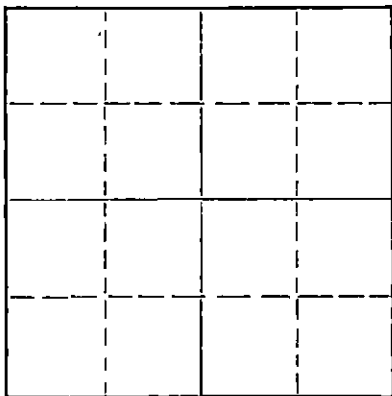

Locate well correctly on above
Section Plat

If a producing well is abandoned, date of last production 19
Was permission obtained from the Conservation Division or its agents before plugging was commenced? verbally - yes.

Name of Conservation Agent who supervised plugging of this well
Producing formation Depth to top Bottom Total Depth of Well 3980 Feet
Show depth and thickness of all water, oil and gas formations.

OIL, GAS OR WATER RECORDS

CASING RECORD

FORMATION	CONTENT	FROM	TO	SIZE	PUT IN	PULLED OUT
				8-5/8"	990	

Describe in detail the manner in which the well was plugged, indicating where the mud fluid was placed and the method or methods used in introducing it into the hole. If cement or other plugs were used, state the character of same and depth placed, from feet to feet for each plug set.

Filled hole with mud to 300'.
Set first plug at 300' with 20 sacks cement.
Filled hole with mud to 35'.
Set second plug at 35' with 10 sacks cement..

(If additional description is necessary, use BACK of this sheet)

Name of Plugging Contractor Musgrove Petroleum Corporation,
Address 518 Petroleum Building, Wichita, Kansas.

STATE OF Kansas, COUNTY OF Sedgwick
I, Wayne R. Davy (employee of owner) or (owner or operator) of the above-described well, being first duly sworn on oath, says: That I have knowledge of the facts, statements, and matters herein contained and the log of the above-described well as filed and that the same are true and correct. So help me God.

(Signature) Wayne R Davy
518 Petroleum Building, Wichita, Kansas.
(Address)

SUBSCRIBED AND SWORN TO before me this 11th day of August, 1954

Thelma L. Stumpp
Notary Public.

My commission expires September 24, 1956.

PLUGGING
FILE SEC 35 T 21 R 10W
BOOK PAGE 55 LINE 43

RECEIVED
STATE CORPORATION COMMISSION
AUG 12 1954
CONSERVATION DIVISION
Wichita, Kansas
8-12-54

CONTRACTOR'S WELL LOG

COMPANY: George Seigrist - Hutchinson
 CONTRACTOR: Musgrove Petroleum Corporation
 FARM: HUTCHERSON #1
 LOCATION: SE SE SW, Sec. 35-21-16
 Pawnee County, Kans.
 COMMENCED: July 22, 1954
 COMPLETED: August 8, 1954

0	42	Surface soil
42	320	Sand shale
320	515	Sand
515	685	Red bed
685	810	Red bed & shale
810	970	Red bed
970	980	Blue shale
980	1090	Anhydrite
1010	1770	Shale
1770	2050	Shale & lime
2050	2080	Shale
2080	3533	Lime & shale
3533	3543	Lansing
3543	3594	Lime & shale
3594	3933	Lime
3933	3962	Lime & shale
3962	3973	Lime
3973	3980	Arbuckle
	3980	Rotary Total Depth

Set 8-5/8" surface casing at 990'

Dry and abandoned.

STATE OF KANSAS)
) SS
 COUNTY OF SEDGWICK)

I, WAYNE R. DAVY, do hereby certify that the above and foregoing is a true and correct copy of the log of the HUTCHERSON #1, SE SE SW, Section 35-21-16, Pawnee County, Kansas, as reflected by the files of the Musgrove Petroleum Corporation.

MUSGROVE PETROLEUM CORPORATION

Wayne R Davy
 Assistant Secretary-Treasurer

Subscribed and sworn to before me, a Notary Public, in and for Sedgwick County, Kansas, this 11th day of August, 1954.

Thomas S. Stuenkel
 Notary Public

My commission expires September 24, 1956.

RECEIVED
 STATE NOTARY PUBLIC COMMISSION

PLUGGING
 FILE SEC 35 T 21 R 16W
 BOOK PAGE 55 LINE 13

CONSERVATION DIVISION
 NOTARY, Kansas