


WELL PLUGGING RECORD

Give All Information Completely
Make Required Affidavit
Mail or Deliver Report to:
Conservation Division
State Corporation Commission
800 Bit Building
Wichita, Kansas

Pawnee County, Sec. 35 Twp. 21 Rge. 16 (E) W (W)

Location as "NE/CNW&SW" or footage from lines Appx. SW NW NW
Lease Owner Duke & Wood Drilling Company
Lease Name Prosser Well No. 1
Office Address Box 123, Great Bend, Kansas
Character of Well (completed as Oil, Gas or Dry Hole) Dry Hole
Date well completed May 23 1954
Application for plugging filed May 23 1954
Application for plugging approved May 23 1954
Plugging commenced May 23 1954
Plugging completed May 23 1954
Reason for abandonment of well or producing formation Dry

NORTH

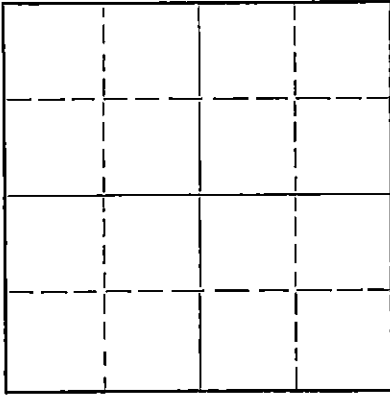

Locate well correctly on above
Section Plat

If a producing well is abandoned, date of last production _____ 19____
Was permission obtained from the Conservation Division or its agents before plugging was commenced? Yes

Name of Conservation Agent who supervised plugging of this well Warren H. Horner
Producing formation _____ Depth to top _____ Bottom _____ Total Depth of Well 3938 Feet
Show depth and thickness of all water, oil and gas formations.

OIL, GAS OR WATER RECORDS

CASING RECORD

FORMATION	CONTENT	FROM	TO	SIZE	PUT IN	PULLED OUT
				8 5/8"	985'	None

Describe in detail the manner in which the well was plugged, indicating where the mud fluid was placed and the method or methods used in introducing it into the hole. If cement or other plugs were used, state the character of same and depth placed, from _____ feet to _____ feet for each plug set.

Filled hole with heavy mud to 360 ft., set bottom plug, dumped 1/2 sack hulls and 20 sacks of cement on plug. Filled hole with Heavy mud to 35ft, set top plug, dumped 1/2 sack of hulls and 10 sacks of cement. Filled hole to bottom of cellar.

(If additional description is necessary, use BACK of this sheet)

Name of Plugging Contractor Duke & Wood Drilling Company
Address Box 123, Great Bend, Kansas

STATE OF Kansas, COUNTY OF Barton, ss.
Lynn C. Duke (employer or operator) of the above-described well, being first duly sworn on oath, says: That I have knowledge of the facts, statements, and matters herein contained and the log of the above-described well as filed and that the same are true and correct. So help me God.

(Signature) Lynn C. Duke
Great Bend, Kansas
(Address)

SUBSCRIBED AND SWORN to before me this 1st day of June, 1954

My commission expires April 29, 1957

Dean T. Cooley
Notary Public
STATE CORPORATION COMMISSION

PLUGGING
FILE SEC 35 T 21 R 16W
BOOK 36 PAGE 23

6-4-54
DIVISION

WELL LOG
SE Prosser #1
Approx. SW NW NW of Sec. 35-21-16W
Pawnee County, Kansas

Started: May 11, 1954
Completed: May 23, 1954

Elevation	1984	KB
Anhydrite	982	(-1002)
Heebner	3398	(-1414)
Iansing	3509	(-1525)
Conglomerate	3797	(-1813)
Viola	3808	(-1824)
Simpson	3875	(-1891)

0-230	Sand
230-310	Blue shale, iron and Dakota sand
310-431	Red bed and sand
431-790	Red bed and sand streaks
790-982	Red bed, shale and clay
982-1023	Anhydrite
1023-1870	Shale and shells
1870-1960	Salt
1960-2145	Shale, shells and limestreaks
2145-2340	Lime and shale
2340-2740	Lime and shale
2740-3175	Lime and shale
3175-3345	Lime
3345-3535	Lime and shale
3535-3797	Lime
3797-3808	Conglomerate
3808-3875	Viola
3875-3938	Simpson sand and conglomerate
3938	TOTAL ROTARY DEPTH

A F F I D A V I T

STATE OF Kansas, COUNTY OF Barton, SS

I, Lynn O. Duke, of the DUKE & WOOD DRILLING COMPANY, being first duly sworn on oath, state; That I have knowledge of the facts, statements and matters herein contained and that the same are true and correct.

PLUGGING
FILE SEC 35-21-16W
BOOK PAGE 36 LINE 23

Lynn O. Duke
Partner

Subscribed and sworn to before me this 2nd day of June, 1954.

RECEIVED
NOTARY COMMISSION

JUN 4 - 1954

My commission expires: April 29, 1957.

Dean T. Looley
Notary Public