


STATE OF KANSAS
STATE CORPORATION COMMISSION

WELL PLUGGING RECORD

FORMATION PLUGGING RECORD

Give All Information Completely
Make Required Affidavit
Mail or Deliver Report to:
Conservation Division
State Corporation Commission
800 Biting Building
Wichita, Kansas

Strike out upper line
when reporting plug-
ging of formations.

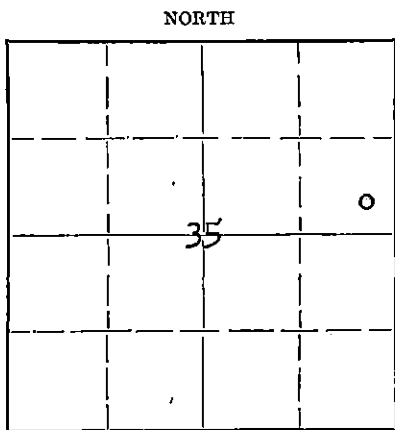

Locate well correctly on above
Section Plat

Pawnee County. Sec. 35 Twp. 21S Rge. 16 X (W)

Location as "NE 1/4 NW 1/4 SW 1/4" or footage from lines. SE SE NE

Lease Owner Imperial Drilling Company, Inc.

Lease Name Prosser Well No. 1

Office Address Wichita 2, Kansas

Character of Well (completed as Oil, Gas or Dry Hole) Dry Hole

Date well completed June 1 19. 52

Application for plugging filed " 19. "

Application for plugging approved " 19. "

Plugging commenced " 19. "

Plugging completed " 19. "

Reason for abandonment of well or producing formation

No commercial production.

If a producing well is abandoned, date of last production - - - 19. - - -

Was permission obtained from the Conservation Division or its agents before plugging was commenced? Yes

Name of Conservation Agent who supervised plugging of this well M. A. Rives, Pratt, Kansas

Producing formation - - - Depth to top - - - Bottom - - - Total Depth of Well 3982 Feet

Show depth and thickness of all water, oil and gas formations.

OIL, GAS OR WATER RECORDS

CASING RECORD

Formation	Content	From	To	Size	Put In	Pulled Out
		0	969	8 5/8"	969'	None

Describe in detail the manner in which the well was plugged, indicating where the mud fluid was placed and the method or methods used in introducing it into the hole. If cement or other plugs were used, state the character of same and depth placed, from - - - feet to - - - feet for each plug set.

Filled hole with heavy mud. Set
bottom plug @ 300 ft. Cemented with
20 Sacks Victor Cement. Set Top Plug
@ 40 ft. cemented with 10 sacks cement.

RECEIVED
STATE CORPORATION COMMISSION

JUL - 3 1952

7-3-52

CONSERVATION DIVISION
Wichita, Kansas

(If additional description is necessary, use BACK of this sheet)

Correspondence regarding this well should be addressed to Imperial Drilling Company, Inc.
Address 903 Union Nat'l. Bank Bldg., Wichita 2, Kansas

STATE OF KANSAS COUNTY OF SEDGWICK, ss.
Raymond L. Bacon (employee of owner) or ~~owner or operator~~ of the above-described well,

being first duly sworn on oath, says: That I have knowledge of the facts, statements, and matters herein contained and the log of the above-described well as filed and that the same are true and correct. So help me God. IMPERIAL DRILLING COMPANY, INC.

(Signature) By: *Raymond L. Bacon*
Wichita, Kansas Vice-President

SUBSCRIBED AND SWORN to before me this 1st day of July, 19 52

Marguerite Pettit
Notary Public.

My commission expires January 4, 1954

PLUGGING
FILE SEC 35 Twp 21 Rge 16
Wichita 2, Kansas

WELL LOG

Imperial Drilling Co., Inc.,

Lease: Prosser
Well No: 1Section 35-21S-16W
SE-SE-NE
Pawnee County, KansasTotal Depth: 3982 ft.
Comm: 5/15/52 Comp: 6/1/52
Contractor: Harms and Knight Drlg. Co.

Casing Record: 8 5/8" set @ 969' cemented w/500 sacks cement, circulated.

Figures indicate bottom of formations:

Sand & Clay	90
Shale & Sand Streaks	255
Shale & Shells	345
Sand	360
Shale	390
Shale & Sand	410
Sand	505
Shale & Red Bed	960
Anhydrite	987
Red Bed	1100
Shale & Shells	1295
Shale	1715
Shale & Shells	1905
Shale & Lime	2165
Lime	2220
Shale & Lime	2410
Shale & Shells	2810
Shale	2920
Shale & Shells	3050
Shale & Lime	3310
Lime	3783
Shale & Lime	3830
Lime	3868
Simpson Shale	3900
Lime	3982
Total Depth	3982'

We hereby certify this to be a correct and accurate log of the above described well as shown on the daily drilling reports.

HARMS & KNIGHT DRILLING CO.

By: *R. A. Gungel*Subscribed and sworn to before me this 17th day of June, 1952.*Charles J. Volk*
Notary Public

My commission expires:

Sept. 15, 1952RECEIVED
STATE CORPORATION COMMISSION
JUL - 3 1952
CONSERVATION DIVISION
Wichita, Kansas