


STATE OF KANSAS  
STATE CORPORATION COMMISSION

WELL PLUGGING RECORD

Give All Information Completely  
Make Required Affidavit  
Mail or Deliver Report to  
Conservation Division  
State Corporation Commission  
311 No. Market  
Wichita, Kansas

NORTH

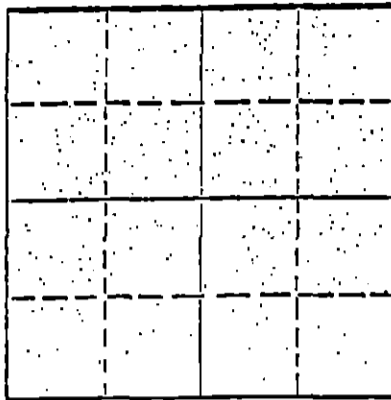

Locate well correctly on above  
Section Plat

Pawnee County, Sec. 36 Twp. 21 Rge. 16 (E) (W)  
Location as "NE/CNW/SE/SW" or footage from lines. SE SW SW  
Lease Owner Mull Drilling Co., Inc.  
Lease Name Prosser Well No. B-3  
Office Address P. O. Box 349 Russell, Kansas 67665  
Character of Well (completed as Oil, Gas or Dry Hole) Cement  
Date well completed \_\_\_\_\_ 10  
Application for plugging filed 12-21-70 10  
Application for plugging approved 12-22-70 10  
Plugging commenced 1-30-71 10  
Plugging completed 2-15-71 10  
Reason for abandonment of well or producing formation \_\_\_\_\_

If a producing well is abandoned, date of last production \_\_\_\_\_ 10  
Was permission obtained from the Conservation Division or its agents before plugging was commenced? Yes

Name of Conservation Agent who supervised plugging of this well Leo Massey  
Producing formation \_\_\_\_\_ Depth to top \_\_\_\_\_ Bottom \_\_\_\_\_ Total Depth of Well 4159 Feet  
Show depth and thickness of all water, oil and gas formations.

OIL, GAS OR WATER RECORDS

CASING RECORD

FORMATION	CONTENT	FROM	TO	SIZE	PUT IN	PULLED OUT
				8 5/8	959	None
				5 1/2	4038	2589'.74

Describe in detail the manner in which the well was plugged, indicating where the mud fluid was placed and the method or methods used in introducing it into the hole. If cement or other plugs were used, state the character of same and depth placed, from \_\_\_\_\_ feet to \_\_\_\_\_ feet for each plug set.

Pushed plug to 2700'; dumped 20 gallons of sand and 5 sacks of cement. Shot casing at 2607'. Laid down 84 joints of 5 1/2" casing. Squeezed well with 2 sacks of hulls, 20 sacks of gel and 100 sacks of 50/50 pozmix cement with 6% gel added.

RECEIVED  
STATE CORPORATION COMMISSION  
FEB 26 1971  
CONSERVATION DIVISION  
Wichita, Kansas

(If additional description is necessary, use BACK of this sheet)  
Name of Plugging Contractor Forbes Casing Pulling Company, Inc.  
Address P. O. Box 221 Great Bend, Kansas 67530

STATE OF Kansas COUNTY OF Barton, ss.  
James W. Rockhold (employee of owner) or (owner or operator) of the above-described

well, being first duly sworn on oath, says: That I have knowledge of the facts, statements, and matters herein contained and the log of the above-described well as filed, and that the same are true and correct. So help me God.

(Signature) James W. Rockhold  
P. O. Box 221 Great Bend, Kansas 67530  
(Address)

Subscribed AND Sworn to before me this 21 day of February, 19 71

Alice Mickel  
NOTARY PUBLIC  
My commission expires May 27, 1973

Alice Mickel  
Notary Public

DRILLING RECORD

15.145.00800-0000

Well #3 F. Prosser "B"  
 Located SE SW SW Sec 36-21S-16W  
 Pawnee County, Kansas

Casing Record

977' of 8-5/8" OD Surface  
 Pipe cemented with 450 sacks.

Work Commenced 8/27/52  
 Drilling Commenced 8/28/52  
 Drilling Completed 9/15/52

4038' of 5 1/2" Casing cemented  
 with 125 sacks.

WELL LOG

Surface Clay & Sand	0 to 40
Sand	40 to 120
Shale & Shells	120 to 250
Blue Shale	250 to 310
Red Bed	310 to 392
Sand	392 to 490
Red Bed	490 to 845
Red Bed & Shells	845 to 849
Anhydrites	849 to 965
Shale	965 to 1200
Shale & Shells	1200 to 1350
Salt & Shale	1350 to 1450
Shale	1450 to 1680
Shale & Shells	1680 to 1835
Lime & Shale	1835 to 1910
Lime & Shale	1910 to 2073
Lime	2073 to 2170
Shale & Lime	2170 to 2325
Lime	2325 to 2342
Lime & Shale	2342 to 2750
Shale	2750 to 2870
Lime & Shale	2870 to 3130
Chert	3130 to 3150
Lime & Shale	3150 to 3179
Lime (Top Br Lime 3486)	3179 to 3487
Lime & Shale	3487 to 3510
Lime	3510 to 3831
Cherty Conglomerate	3831 to 3861
Conglomerate	3861 to 3874
Shale	3874 to 3929
Lime	3929 to 3940
Arbuckle	3940 to 3991
Lime	3991 to 4076
Cherty Lime	4076 to 4095
Lime	4095 to 4159

RECEIVED  
 STATE CORPORATION COMMISSION  
 DEC 23 1970  
 CONSERVATION DIVISION  
 Wichita, Kansas